

KANICAS


Rice

FORM 51 SM 1-42 PETROL

Section 36 Township 20 Range 8-W


Well No. #3 Carlson

Company Continental

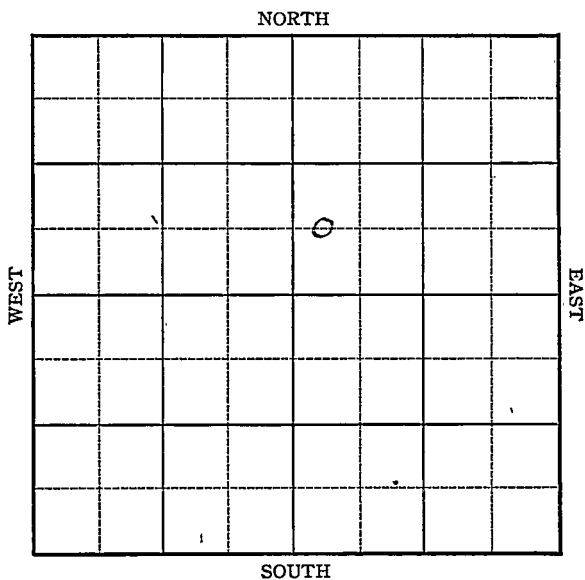

Sec. 36 Twp. 20 R. 6-WWell No. #3 Carlson FarmContinental Company

NORTH

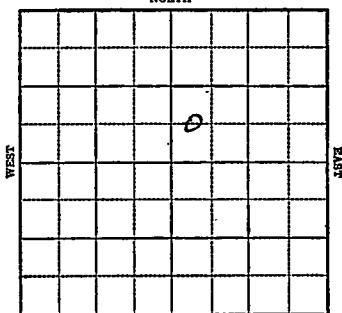

SOUTH

         Ft. from N. Line660 Ft. from S. Line         Ft. from E. Line330 Ft. from W. Line

Elev. 1526

1944

## R E P O R T

1-19 Location

1/26 Rotary

2/2 "

2/8 10" @ 161  
Miss 3304  
TD 3308  
6" @ 3304  
Rust

2/15 "

2/23 6" @ 3304  
Miss 3304  
TD 3348  
Pump 400 Pot.  
Gravity 39


COMPLETED

KANSAS  
Map No. 48 Sec. 36 Twp. 20 R. 6WWell No. 3 CarlsonContinental Company

FIRST REPORT Contractor

C W L SW NE

## SECTION PLAT

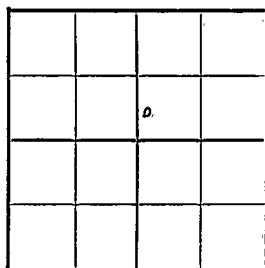         Ft. from N. Line660 Ft. from S. Line         Ft. from E. Line330 Ft. from W. LineBornholdt PoolLocation XRig up         

Drilling and Remarks:

## RECORD

Cased          in.,          ft.Sand         Gas         Oil         Total Depth         

## PRODUCTION

1st 24 hrs. Nat.         1st 24 hrs. after shot         Gas          Cu. Ft.Dry Hole         Abandoned         

Date

JAN 19 1944 19S. J. LEWIS Scout

Rice

KANSAS

Map No. 48 Sec. 36 Twp. 20 R. 6WWell No. 3 CarlsonContinental CompanyCOMPLETED Contractor

C W L SW NE

## SECTION PLAT

|  |  |   |  |
|--|--|---|--|
|  |  |   |  |
|  |  | 2 |  |
|  |  |   |  |
|  |  |   |  |

         Ft. from N. Line660 Ft. from S. Line         Ft. from E. Line330 Ft. from W. Line

Bornholdt Pool

Location                                 Rig up                                 

Drilling and Remarks:

*Wire 3304**6 "C3304**Pump 400 B.D.**392 Gr*

## RECORD

Cased          in.,          ft.Sand                                 Gas                                 Oil                                 Total Depth 3348

## PRODUCTION

1st 24 hrs. Nat.                                 1st 24 hrs. after shot                                 Gas                                  Cu. Ft.Dry Hole                                 Abandoned                                 

Date

FEB 23 1944 19

S. J. LEWIS Scout