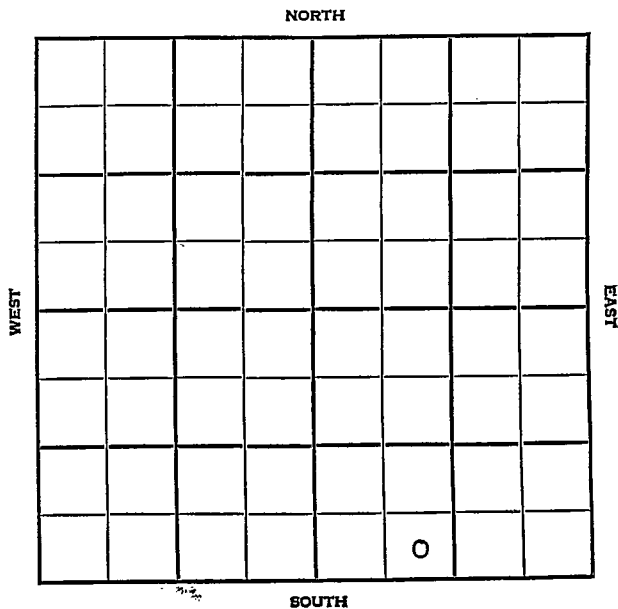


Section 36 Township 20 Range 6 WWell No. #1 CarlsonCompany Sterling Drlg. & Davis Childs

Rice

KANSAS

SEC.	TWP.	R..
36	20	6W

WELL NO.

#1 Carlson

FARM

COMPANY

Sterling Drlg. & Davis-Childs

CONTRACTOR

Co. Tools

Welch-Bornhold


_____ Ft. from N. Line

_____ Ft. from S. Line

_____ Ft. from E. Line

_____ Ft. from W. Line

SE SW SE

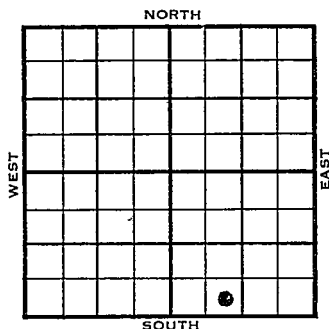

1955	ELEVATION 1521'	REPORT
------	--------------------	--------

8/3

Comm 7-29-55

FIRST REPORT

8" @120/100 Drlg. 1380

9-7

5½" @ 3332

Pmp 15 bopd plus 70% wtr.

Tops: M. 3330

T.D. 3334'

COMPLETED

County Rice Elev. _____
 Sec. 36 Twp. 20 Rge. 6W
 Company Sterling Drlg. & Davis-Childs
 Farm Name Carlson No. 1

TOPS	DEPTH	LOG	DATUM
Anh.			
TP.			
H.			
Tr.			
Dg.			
BL.			
L.			
K.C.			
B.K.C.			
Ce.			
C.			
M.			
M.			
K.			
Mz.			
Me.			
V.			
S.			
S.			
A.			
R.			
PE.			
G.			
T.D.			

Loc. in Sec. _____

SE SW SE

Geol. _____

Contr. _____

Co. tools _____

Pool _____

Welch-Bornhold _____

FIRST REPORT

AUG 3 '55

0

Date Comm. 7-29-55
8" @ 120/100 drlg. 1380

1/2

County Rice Elev. 1521
 Sec. 36 Twp. 20 Rge. 6W
 Company Sterling Drlg. & Davis-Childs
 Farm Name Carlson No. 1

Co.

Lse.

No.

Sec.

T.

R.

TOPS	DEPTH	LOG	DATUM
Anh.			
Tr.			
H.			
Dg.			
BL.			
L.			
K.C.			
B.K.C.			
Ce.			
C.			
M.	3330		1809
M.			
K.			
Mz.			
Mo.			
V.			
S.			
S.			
A.			
R.			
PE.			
G.			
T.D.	3334		

Loc. in Sec.

SE SW SE

Geol.

Contr.

Co. tools

Pool

Welch-Bornhold

COMPLETE

Date Comm. 7/29/55 SEP 7 19558th 120 w/100 5¹/₂" 3332

Pmp 15 bopd plus 70% wtr