

KANSAS


Rice

FORM 51 5M 4-41 PETROL

Section 36 Township 20 Range 6-W

Well No. #1 Harder

Company Westgate-Greenland

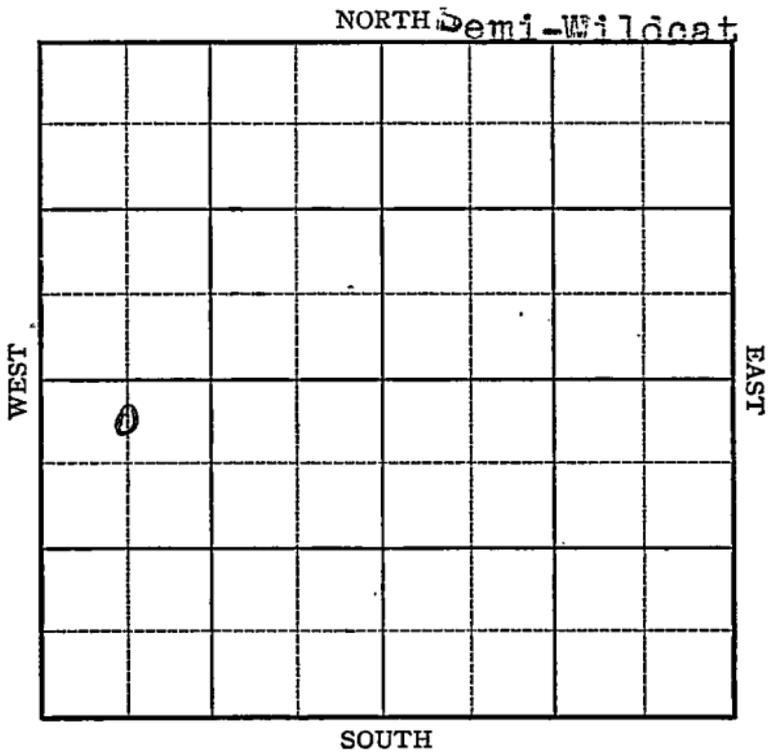

Sec. 35 Twp. 20 R. 6-W

Well No. #1 Harder Farm

Westgate-Greenland Company

(Semi-Wildcat)


330 Ft. from N. Line

_____ Ft. from S. Line

_____ Ft. from E. Line

660 Ft. from W. Line

Elev. 1543

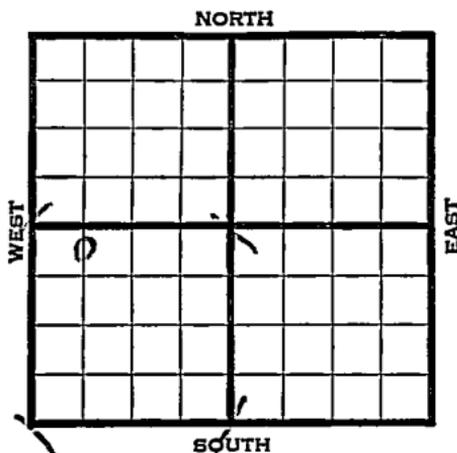

1941	REPORT
10/1	Location
10/16	Rotary.
10/23	10" - 152' Lans. 2850' 2945'
	Drlg. 3083'
10/30	Lans. 2945' (Corrected)
	Cong. 3317' Miss. 3326 $\frac{1}{2}$ '
	7" - 3327' RUST.
11/6	" " "
11/13	T.D. 3375' 700' fluid 12 hrs.,
	10% water.
11/20	" "
11/25	Miss. 3326 $\frac{1}{2}$ '
	7" - 3327'
	T.D. 3415'
	P.B. to 3376'
	600 Butane.
	Pump 45 oil plus 21 water.
	38.4 Gravity
	COMPLETED

KANSASMap No. K-48 Sec. 36 Twp. 20 R. 6WWell No. 1 HarderWestgate-Greenland

Company

FIRST REPORT

Contractor

SECTION PLAT

C NL NW SW

330 Ft. from N. Line

_____ Ft. from S. Line

330 Ft. from E. Line660 Ft. from W. Line

SEMI-WILDCAT

o			

Location _____

Rig up _____

Drilling and Remarks:

RECORD

Cased _____ in., _____ ft.

Sand _____

Gas _____

Oil _____

Total Depth _____

PRODUCTION.

1st 24 hrs. Nat. _____

1st 24 hrs. after shot _____

Gas _____ Cu. Ft.

Dry Hole _____

Abandoned _____

Date

Oct 1 1941

S. J. LEWIS Scout

Rice

KANSAS

Map No. K-48 Sec. 36 Twp. 20 R. 6W

Well No. 1 Harder

Westgate-Greenland Company

COMPLETED Contractor

C NL NW SW

SECTION PLAT

330 Ft. from N. Line

_____ Ft. from S. Line

_____ Ft. from E. Line

660 Ft. from W. Line

o			

SEMI-WILDCAT

Location _____

Rig up _____

Drilling and Remarks:

Misc 332 1/2
7" C 3327
P 33376
600 Bu tax
Pump 45 oil + 21 Water
38# Gr

RECORD

Cased _____ in., _____ ft.

Sand _____

Gas _____

Oil _____

Total Depth 2415

PRODUCTION

1st 24 hrs. Nat. _____

1st 24 hrs. after shot _____

Gas _____ Cu. Ft.

Dry Hole _____

Abandoned _____

Date

NOV 25 1941 19

S. J. LEWIS Scout