


Section 4 Township 20 Range 9-W

Well No. #2 McGlynn

Company Herndon Drilling

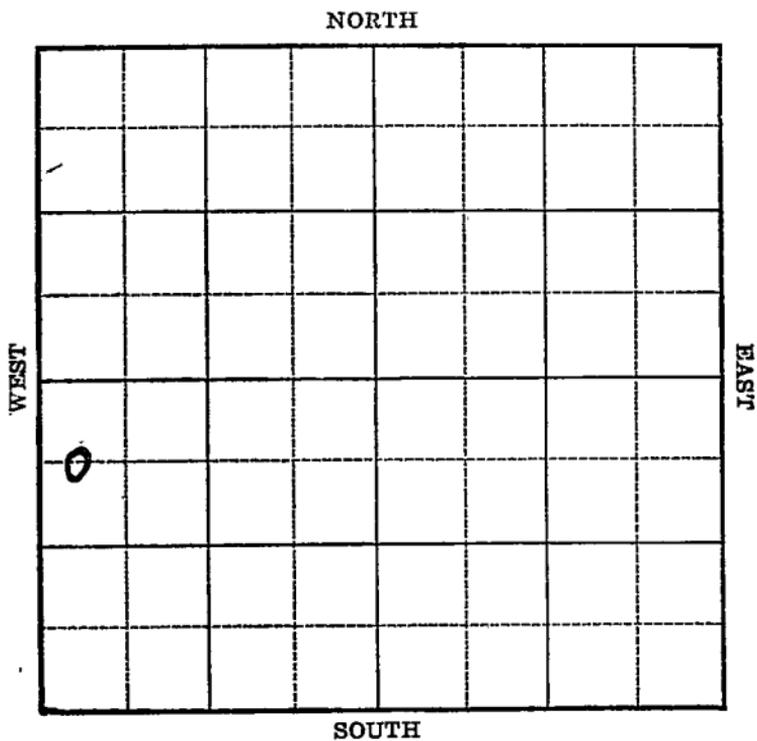

KANSAS

Rice

Sec. 4 Twp. 20 R. 9-W

Well No. #2 McGlynn Farm

Herndon Drilling Company

(Chase)


660 Ft. from N. Line

_____ Ft. from S. Line

_____ Ft. from E. Line

330 Ft. from W. Line

Elev. 1718

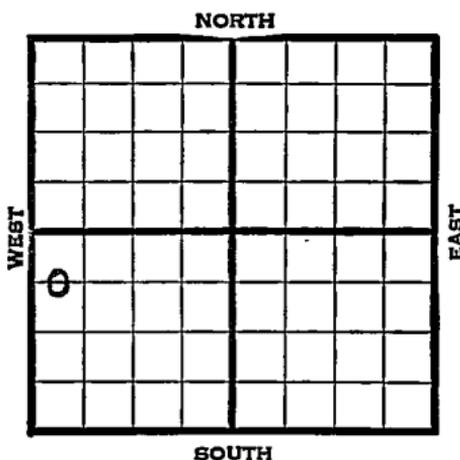

1939	REPORT
7/19	Rotary.
7/27	10" - 225' Drlg. 700'
8/3	Arb. 3253' Drlg.
8/10	5½" - 3252' T.D. 3259½'
	250 acid. No help.
	500 acid. No test.
8/17	1100 acid. No help.
8/24	Total acid 2750 gals.
	Pump 35 bbls. 3 hours.
	Shut down.
8/31	" "
	-
9/6	Arb. 3253'
	5½" - 3252'
	T.D. 3259½'
	2750 acid.
	Potential 248 oil & 4 water on pump.
	COMPLETED

Rice

Map No. 44 Sec. 4 Twp. 20 R. 9WWell No. 2 McGlynnHerndon Drilling Company

Contractor

FIRST REPORT

C W L NW SW

660 Ft. from N. Line

_____ Ft. from S. Line

_____ Ft. from E. Line

330 Ft. from W. Line

SECTION PLAT

0			

CHASE POOL

Location _____

Rig up _____

Drilling and Remarks:

Rotary

RECORD

Cased _____ in., _____ ft.

Sand _____

Gas _____

Oil _____

Total Depth _____

PRODUCTION

1st 24 hrs. Nat. _____

1st 24 hrs. after shot _____

Gas _____ Cu. Ft.

Dry Hole _____

Abandoned _____

Date

JUL 19 1939

S. J. LEWIS Scout

Rice

Map No. 49 Sec. 4 Twp. 20 R. 9W

Well No. 2 McGlynn

Herndon Drilling Company

Contractor

COMPLETED

SECTION PLAT

C W L NW SW
660 Ft. from N. Line
 _____ Ft. from S. Line
 _____ Ft. from E. Line
330 Ft. from W. Line

0			

CHASE POOL

RECORD

Location _____

Cased _____ in., _____ ft.

Rig up _____

Sand _____

Drilling and Remarks:

Gas _____

*Ac 83253
 5 1/2" C3252
 2750 R. C. C.
 Pump 248 oil
 4 Water P.T.*

Oil _____

Total Depth 3259 1/2

PRODUCTION

1st 24 hrs. Nat. _____

1st 24 hrs. after shot _____

Gas _____ Cu. Ft.

Dry Hole _____

Abandoned _____

Date

SEP 6 1939

S. J. LEWIS Scout