


Section 4 Township 20 Range 9W

Well No. #2 McGlynn "A"

Company Gabert & Lindas
Chase Pool

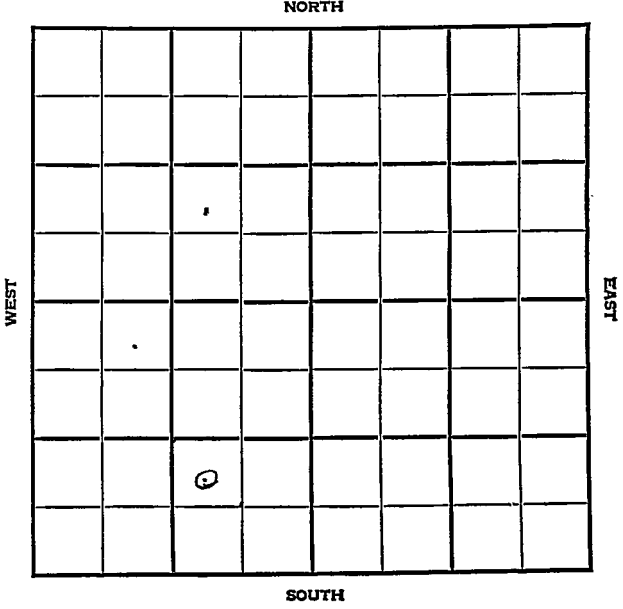


Sec. 4 **KANSAS** Twp. 20 R. 9W

Well No. #2 McGlynn "A" Farm

Gabert & Lindas Company

Chase Pool

_____ Ft. from N. Line
990 Ft. from S. Line
990 Ft. from E. Line
_____ Ft. from W. Line

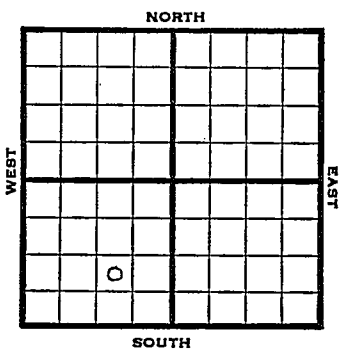

NW SE SW

1948

Elev. 1713' REPORT

- 4/21 Location
- 4/28 "
- 5/5 "-
- 5/12 RUR
- 5/19 10" @ 211'
Drlg. 2210'
- 5/26 Arbuckle 3210'
TD 3230'
5" @ 3217'
RUST
- 6/11 TD 3230'
100 Acid
- 6/9 Arb. 3210'
5" @ 3217'
Pump 100 pot
42.0 Gr.
TD 3230'
Comp.

COMPLETED

Map No. _____ Sec. 4 Twp. 20 R. 9W

Well No. 2 McGlynn "A"

Gabert & Lindas Company

FIRST REPORT

Contractor

NW SE SW

SECTION PLAT

_____ Ft. from N. Line

990 Ft. from S. Line

990 Ft. from E. Line

_____ Ft. from W. Line

	o		

Rice County

Location X

Rig up _____

Drilling and Remarks:

RECORD

Cased _____ in., _____ ft.

Sand _____

Gas _____

Oil _____

Total Depth _____

PRODUCTION

1st 24 hrs. Nat. _____

1st 24 hrs. after shot _____

Gas _____ Cu. Ft.

Dry Hole _____

Abandoned _____

Date

APR 21 1948

19

S. J. LEWIS Scout

Map No. 49 Sec. 4 Twp. 20 R. 9W

Well No. 2 McGlynn "A"

Gabert & Lindas Company

COMPLETE

Contractor

SW SE SW

E/ 1713
SECTION PLAT

_____ Ft. from N. Line

330 Ft. from S. Line

990 Ft. from E. Line

_____ Ft. from W. Line

Rice County

Location _____

Rig up _____

Drilling and Remarks:

Case 3210

5" 3210

Pump 100 ft

42 3/4

RECORD

Cased _____ in., _____ ft.

Sand _____

Gas _____

Oil

Total Depth 3200

PRODUCTION

1st 24 hrs. Nat. _____

1st 24 hrs. after shot _____

Gas _____ Cu. Ft.

Dry Hole _____

Abandoned _____

Date

JUN 9 . 1948 19

S. J. LEWIS Scout