

KANSAS


Rice

FORM 51 5M 4-41 PETROL

Section 4 Township 20 Range 9W

Well No. #2 Mitchell

Company Luther MacKall et al

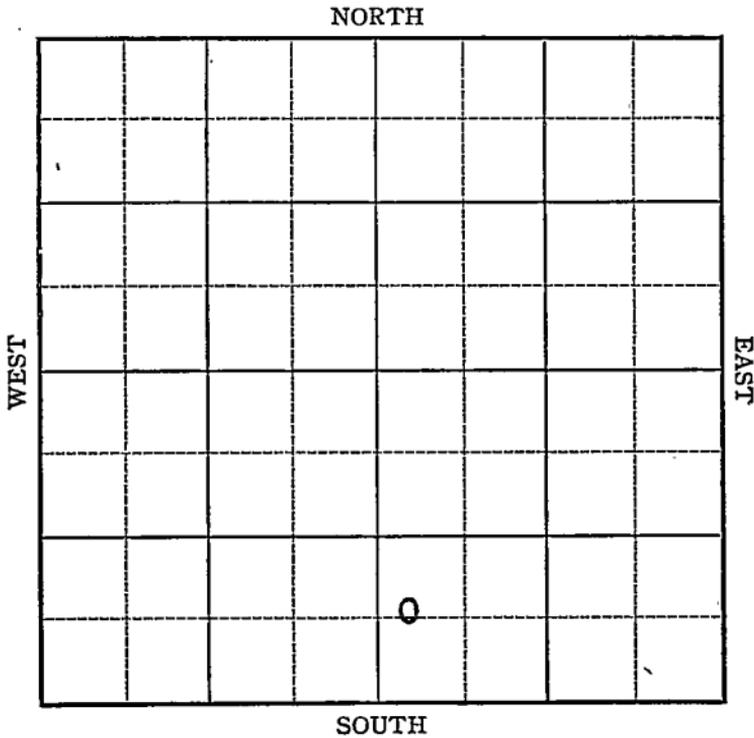

Map No. _____ Sec. 4 Twp. 20 R. 9WWell No. 2 MitchellLuther MacKall et al CompanyFIRST REPORT Contractor

SECTION PLAT

C W L SW SE

_____ Ft. from N. Line

660 Ft. from S. Line

_____ Ft. from E. Line

330 Ft. from W. Line

		o	

KRESLING POOL

Location _____

Rig up _____

Drilling and Remarks:

8" - 199Drlg, 1920

RECORD

Cased _____ in., _____ ft.

Sand _____

Gas _____

Oil _____

Total Depth _____

PRODUCTION

1st 24 hrs. Nat. _____

1st 24 hrs. after shot _____

Gas _____ Cu. Ft.

Dry Hole _____

Abandoned _____

Date

SEP 3 1941 19S. J. LEWIS Scout

Map No. A-49 Sec. 4 Twp. 20 R. 9WWell No. 2 MitchellLuther MacKall etal CompanyCOMPLETED

Contractor

C WL SW SE

SECTION PLAT

 Ft. from N. Line660 Ft. from S. Line Ft. from E. Line330 Ft. from W. Line

KEESLING POOL

Location Rig up

Drilling and Remarks:

*Cr 82234**4" @ 3236**2000 acs/c**Pump 406 P.V.**H.S. Jr*

RECORD

Cased in., ft.Sand Gas Oil Total Depth 3239 1/2

PRODUCTION

1st 24 hrs. Nat. 1st 24 hrs. after shot Gas Cu. Ft.Dry Hole Abandoned

Date

SEP 24 1941₁₉S. J. LEWIS Scout