

KANSAS

Rice


FORM 51 5M 4-41 PETROL

Section 4 Township 20 Range 9-W

Well No. #3 Mitchell

Company Luther Mackall

Keesling Pool

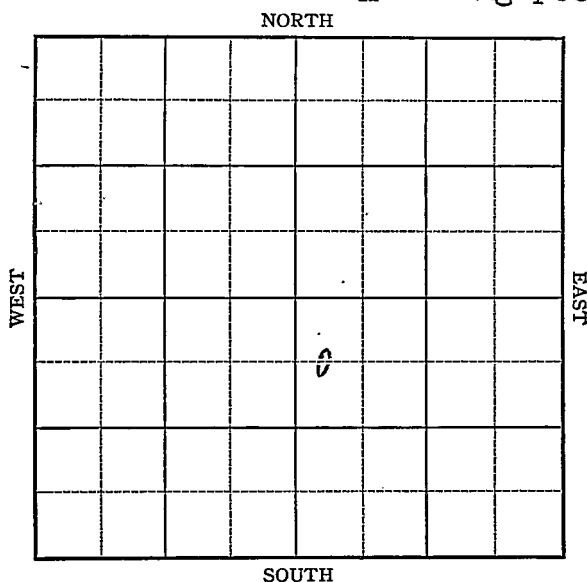

Map No. K-49 Sec. 4 Twp. 20 R. 9WWell No. 3 MitchellLuther Mackall Company

Contractor

FIRST REPORT

C WL NW SE

660 Ft. from N. Line Ft. from S. Line Ft. from E. Line330 Ft. from W. Line

SECTION PLAT

		D	

KEESLING POOL

Location Rig up

Drilling and Remarks:

Rotary

RECORD

Cased in. ft.Sand Gas Oil Total Depth

PRODUCTION

1st 24 hrs. Nat. 1st 24 hrs. after shot Gas Cu. Ft.Dry Hole Abandoned

Date

OCT 1 1941 19S. J. LEWIS Scout

Map No. 4-40 Sec. 4 Twp. 20 R. 9WWell No. 3 MitchellLuther Mackall CompanyCOMPLETED Contractor

C WL NW SE

SECTION PLAT

		6	

660 Ft. from N. Line Ft. from S. Line Ft. from E. Line330 Ft. from W. Line

KEESLING POOL

Location Rig up

Drilling and Remarks:

Cr 83232.4" C 3233Pump 60 oil &
60 Water P. &.43 1/2 Gr

RECORD

Cased in., ft.Sand Gas Oil Total Depth 3245

PRODUCTION

1st 24 hrs. Nat. 1st 24 hrs. after shot Gas Cu. Ft.Dry Hole Abandoned

Date

NOV 5 1941 19S. J. LEWIS Scout