


Section 4 Township 20 Range 9-W

Well No. #2 McGlynn

Company Herndon Drilling

Keesling Pool

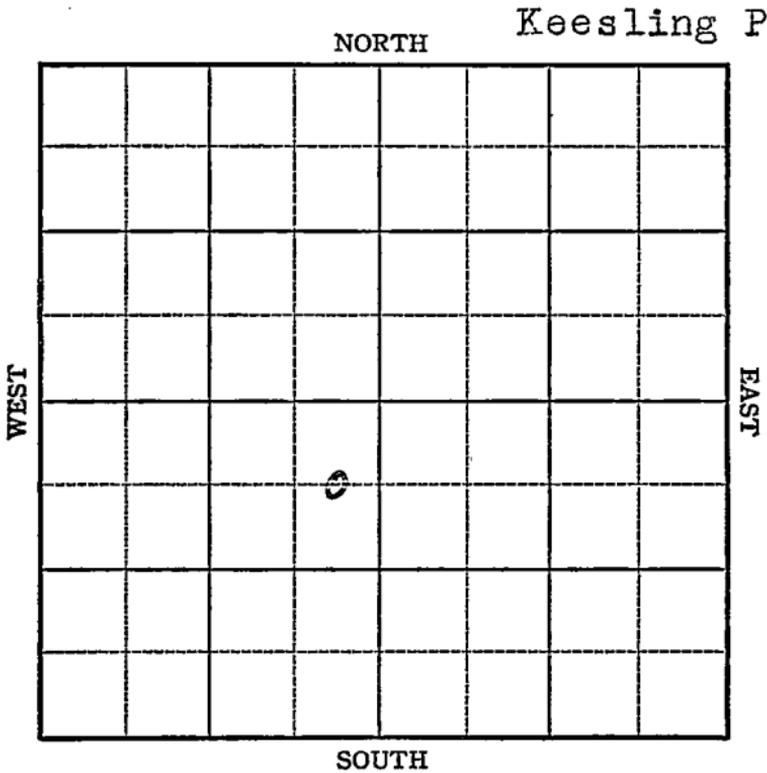

Sec. 4 Twp. 20 R. 9-W

Well No. #2 McGlynn Farm \_\_\_\_\_

Herndon Drilling Company

(Keesling)


660 Ft. from N. Line

\_\_\_\_\_ Ft. from S. Line

330 Ft. from E. Line

\_\_\_\_\_ Ft. from W. Line

Elev. 1709

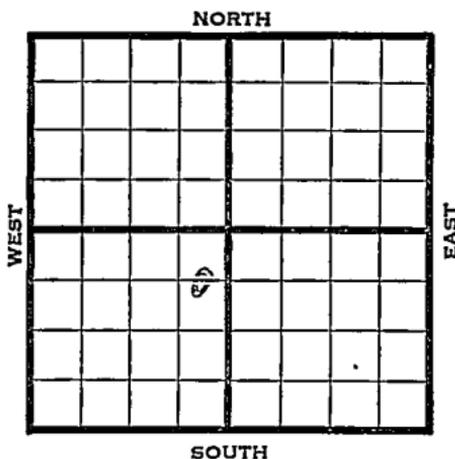

1942	REPORT
4/15	Derrick.
4/22	"
4/29	"
5/6	10" - 200' Drlg. 1905'
5/13	Arb. 3233' T.D. 3235'
	5" - 3234' RUST.
5/20	T.D. 3244' 5 oil per hour.
	2500 acid.
5/27	Arb. 3233'
	5" - 3234'
	T.D. 3244'
	2500 acid.
	Potential 203 bbls., pump.
	44.5 Gravity
	<b>ABANDONED</b>

Map No. 49 Sec. 4 Twp. 20 R. 9WWell No. 2 McGlynnHerndon Drilling CompanyFIRST REPORT Contractor

C E L N E S W

SECTION PLAT

660 Ft. from N. Line

\_\_\_\_\_ Ft. from S. Line

330 Ft. from E. Line

\_\_\_\_\_ Ft. from W. Line

		o	

KEESLING POOL

## RECORD

Location \_\_\_\_\_

Cased \_\_\_\_\_ in., \_\_\_\_\_ ft.

Rig up \_\_\_\_\_

Sand \_\_\_\_\_

Drilling and Remarks:

Gas \_\_\_\_\_

Oil \_\_\_\_\_

Derrick

Total Depth \_\_\_\_\_

## PRODUCTION

1st 24 hrs. Nat. \_\_\_\_\_

1st 24 hrs. after shot \_\_\_\_\_

Gas \_\_\_\_\_ Cu. Ft.

Dry Hole \_\_\_\_\_

Abandoned \_\_\_\_\_

Date

APR 15 1942 19S. J. LEWIS Scout

Rice

KANSAS

Map No. 49 Sec. 4 Twp. 20 R. 9WWell No. 2 McGlynnHerndon Drilling CompanyCOMPLETED Contractor

C E L N E S W


SECTION PLAT

660 Ft. from N. Line

\_\_\_\_\_ Ft. from S. Line

330 Ft. from E. Line

\_\_\_\_\_ Ft. from W. Line

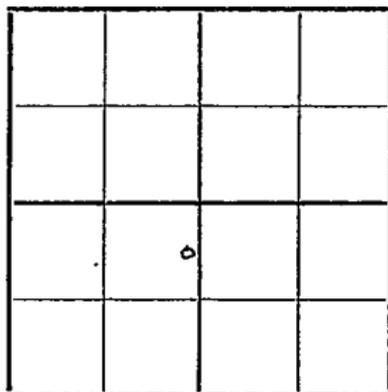

KEESLING POOL

## RECORD

Location \_\_\_\_\_

Cased \_\_\_\_\_ in., \_\_\_\_\_ ft.

Rig up \_\_\_\_\_

Sand \_\_\_\_\_

Drilling and Remarks:

Gas \_\_\_\_\_

Oil \_\_\_\_\_

Total Depth 3244

## PRODUCTION

1st 24 hrs. Nat. \_\_\_\_\_

1st 24 hrs. after shot \_\_\_\_\_

Gas \_\_\_\_\_ Cu. Ft.

Dry Hole \_\_\_\_\_

Abandoned \_\_\_\_\_

Date

MAY 27 1942 19S. J. LEWIS Scout

*Per #3233  
5" @ 3234  
2500 acid  
Pump 203 PT.  
44 5/8 in*