


Section 4 Township 20 Range 9-W

Well No. #4 Mitchell

Company Luther Mackall

NORTH Keesling Pool

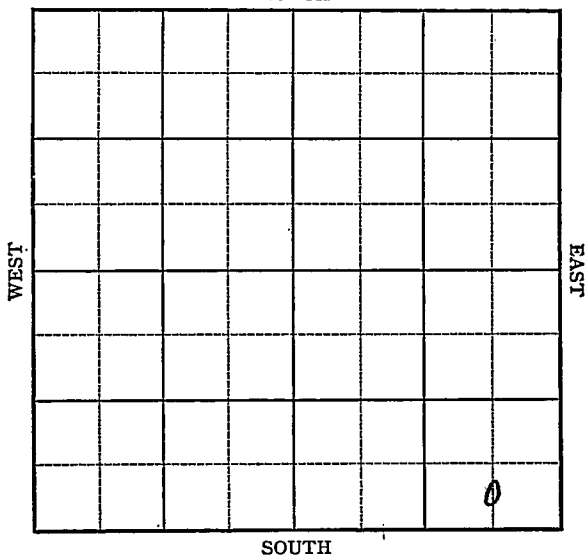



Map No. K-49 Sec. 4 Twp. 20 R. 9WWell No. 4 MitchellLuther Mackall CompanyFIRST REPORT Contractor

C SL SE SE

## SECTION PLAT

         Ft. from N. Line330 Ft. from S. Line660 Ft. from E. Line         Ft. from W. Line


KEESLING POOL

Location                                 Rig up                                 

Drilling and Remarks:

Rotary

## RECORD

Cased          in.,          ft.Sand                                 Gas                                 Oil                                 Total Depth                         

## PRODUCTION

1st 24 hrs. Nat.                         1st 24 hrs. after shot                         Gas                                  Cu. Ft.Dry Hole                                 Abandoned                                 

Date

OCT 15 1941 19

S. J. LEWIS

Scout

Rice

**KANSAS**Map No. H. 49 Sec. 4 Twp. 20 R. 9WWell No. 4 MitchellLuther Mackall CompanyCOMPLETED Contractor

C SL SE SE

## SECTION PLAT

			o

         Ft. from N. Line330 Ft. from S. Line660 Ft. from E. Line         Ft. from W. Line

## KEESLING POOL

Location                                 Rig up                                 

Drilling and Remarks:

*Cor 8240*  
*5" @ 3241*  
*2000 acid*  
*Pump # 2307*

*43 5/8 in*

## RECORD

Cased          in.,          ft.Sand                                 Gas                                 Oil                                 Total Depth 3242

## PRODUCTION

1st 24 hrs. Nat.                         1st 24 hrs. after shot                         Gas                                  Cu. Ft.Dry Hole                                 Abandoned                                 

Date

NOV 25 1941 19S. J. LEWIS Scout