


Section 4 Township 20 Range 9 W

Well No. #1 Peterson

Company Musgrove Petroleum

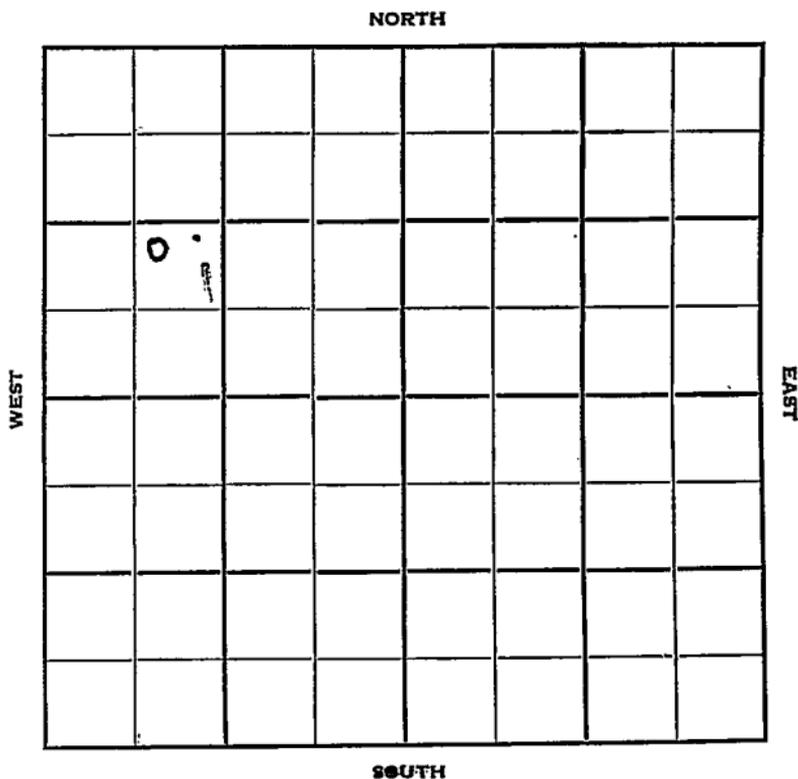

Rice
20

ANSAS
9W ✓

Sec. 4 Twp. _____ R. _____

Well No. #1 Peterson Farm _____

Musgrove Petroleum Company _____

Mallard Drlg -Contr. Contractor _____

Chase Pool


1450' Ft. from N. Line

_____ Ft. from S. Line

_____ Ft. from E. Line

810' Ft. from W. Line

NE SW NW

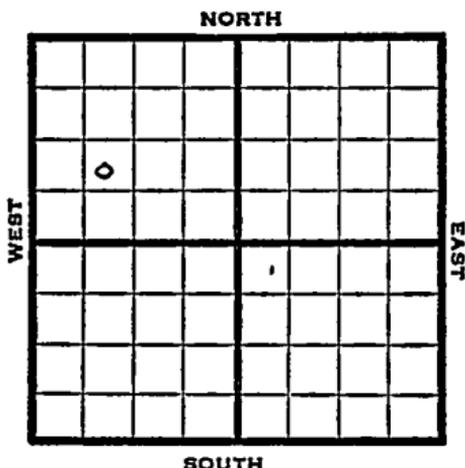

1951 Elev. 1711' REPORT

1/17 Spud 1-11-51
8" @ 208'
Drlg. 2511'

1/24 Spud 1-11-51
D&A TD 3247
8" @ 208' Heeb. 2758'
Br Line 2887' Lans. 2913
Arb. 3243' TD 3247
D&A

ABANDONED

