


Section 4 Township 20 Range 9-W

Well No. 1 Peterson

Company C. H. Weaver

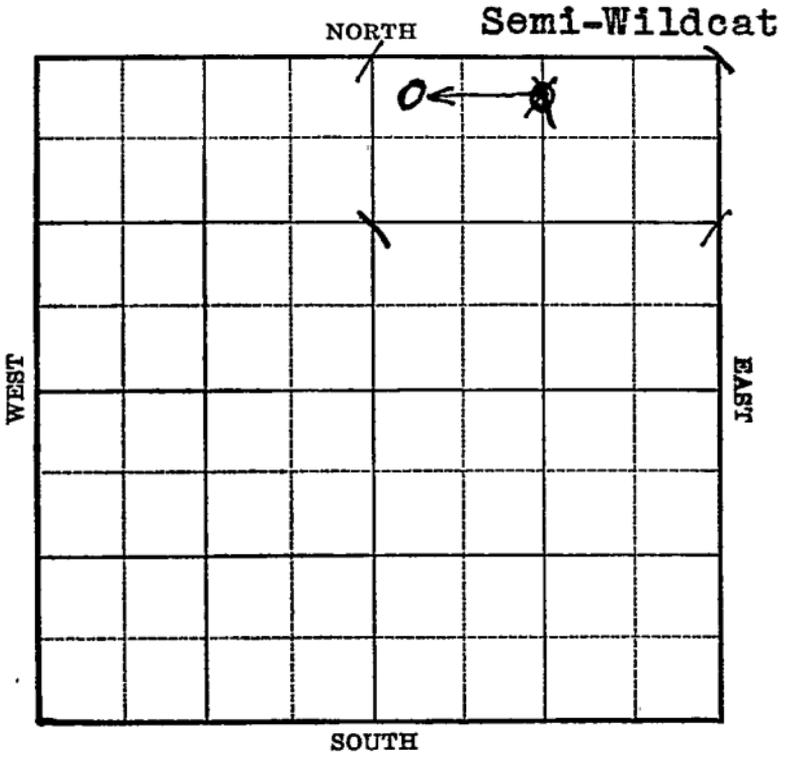



1939

5/17

Arb. 3233'

5" - 3238'

T. D. 3260'

P. B. to 3258'

750 acid.

15 bbls.

COMPLETED

Map No. 49 Sec. 4 Twp. 20 R. 9WWell No. 1 PetersonC. H. Weaver Company

Contractor

**FIRST REPORT**

C N L NE


330 Ft. from N. Line

\_\_\_\_\_ Ft. from S. Line

1320 Ft. from E. Line

\_\_\_\_\_ Ft. from W. Line

SEMI-WILDCAT

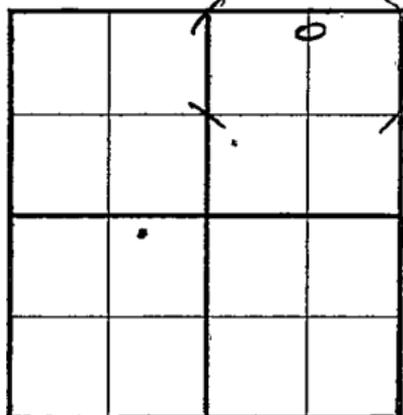**SECTION PLAT**Location X

Rig up \_\_\_\_\_

Drilling and Remarks:

**RECORD**

Cased \_\_\_\_\_ in., \_\_\_\_\_ ft.

Sand \_\_\_\_\_

Gas \_\_\_\_\_

Oil \_\_\_\_\_

Total Depth \_\_\_\_\_

**PRODUCTION**

1st 24 hrs. Nat. \_\_\_\_\_

1st 24 hrs. after shot \_\_\_\_\_

Gas \_\_\_\_\_ Cu. Ft.

Dry Hole \_\_\_\_\_

Abandoned \_\_\_\_\_

Date

MAR 15 1939

19

E. D. Hatfield Scout

Rice KANSAS

Map No. 49 Sec. 4 Twp. 20 R. 9<sup>w</sup>

Well No. 1 - Peterson

C. H. Weaver Company

Contractor

NW NE


CORRECTION SECTION PLAT

330 Ft. from N. Line

\_\_\_\_\_ Ft. from S. Line

\_\_\_\_\_ Ft. from E. Line

330 Ft. from W. Line

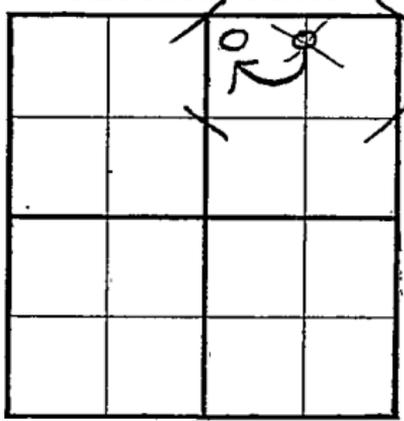

CORRECTION

Location \_\_\_\_\_

Rig up \_\_\_\_\_

Drilling and Remarks:

LOCATION MOVED  
FROM CNL NE  
TO NW NE

RECORD

Cased \_\_\_\_\_ in., \_\_\_\_\_ ft.

Sand \_\_\_\_\_

Gas \_\_\_\_\_

Oil \_\_\_\_\_

Total Depth \_\_\_\_\_

PRODUCTION

1st 24 hrs. Nat. \_\_\_\_\_

1st 24 hrs. after shot \_\_\_\_\_

Gas \_\_\_\_\_ Cu. Ft.

Dry Hole \_\_\_\_\_

Abandoned \_\_\_\_\_

Date

MAR 22 1939

H. D. Hatfield

19

Scout

**Rice**

Map No. 49 Sec. 4 Twp. 20 R. 9W

Well No. 1 Peterson

C. H. Weaver Company

Contractor

**COMPLETED**

**NW NE**

330 Ft. from N. Line

\_\_\_\_\_ Ft. from S. Line

\_\_\_\_\_ Ft. from E. Line

330 Ft. from W. Line

**SECTION PLAT**


**SEMI-WILD CAT**

Location \_\_\_\_\_

Rig up \_\_\_\_\_

Drilling and Remarks:

*Ar 8.3233  
5" @ 3238  
PB 3258.  
750 acid  
15 ft. h.*

**RECORD**

Cased \_\_\_\_\_ in., \_\_\_\_\_ ft.

Sand \_\_\_\_\_

Gas \_\_\_\_\_

Oil \_\_\_\_\_

Total Depth 3260

**PRODUCTION**

1st 24 hrs. Nat. \_\_\_\_\_

1st 24 hrs. after shot \_\_\_\_\_

Gas \_\_\_\_\_ Cu. Ft.

Dry Hole \_\_\_\_\_

Abandoned \_\_\_\_\_

Date

MAY 17 1939 19

S. J. LEWIS Scout