


Form 51-5M-2-29-34703

Map No. KANSAS Sec. 4 Twp. 20 R. 9w

Well No. 1 Wells E.H. Langston Farm _____

Company _____

NORTH

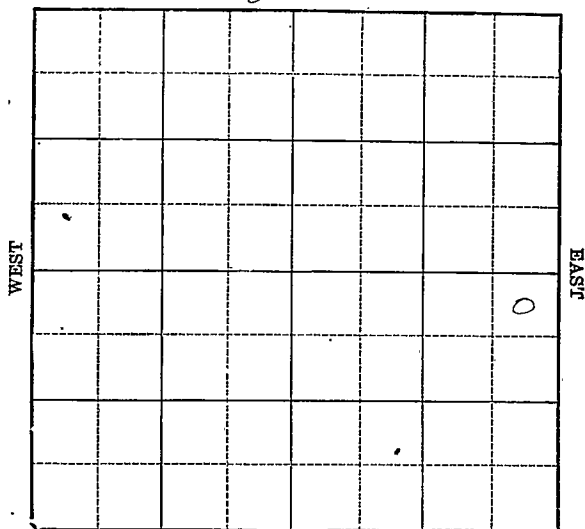

SOUTH

Location _____

Drilling Remarks _____

Rig Up _____

Drilling Remarks _____

RECORD

Cased _____ in. _____ ft.

Sand _____

Gas _____

Oil _____

Total Depth _____

PRODUCTION

1st 24 hrs. Nat. _____

1st 24 hrs. after shot _____

Gas _____ cu. ft.

Dry Hole _____

Abandoned _____


Map No. KANSAS Sec. 4 Twp. 20 R. 9th
 Well No. 1- Wells Farm
E. H. Langston Company

330 Ft. from N. Line

 Ft. from S. Line

330 Ft. from E. Line

 Ft. from W. Line

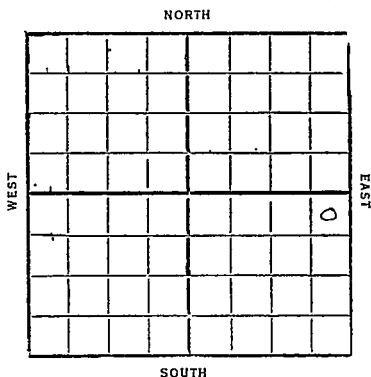

1932

Date	REPORT
5/18	<u>Reg.</u>
5/25	<u>Reg.</u>
6/11	<u>—</u>
6/18	<u>—</u>
6/15	<u>—</u>
6/22	<u>—</u>
6/29	<u>—</u>
7/6	<u>—</u>
7/13	<u>—</u>
7/20	<u>—</u>
7/27	<u>—</u>
8/3	<u>—</u>
8/10	<u>—</u>
8/17	<u>—</u>
8/24	<u>—</u>
8/31	<u>—</u>
9/7	<u>Regn up</u>
9/14	<u>Regd up + SD</u>
9/21	<u>—</u>
9/30	<u>— 10/19 — 11/9 —</u>
10/5	<u>— 10/26 — 11/16 —</u>
10/12	<u>— 11/2 — 11/23 —</u>

49 **KANSAS** *Rice*
 Map No. _____ Sec. 4 Twp. 20 R. 9 ^W

Well No. 1 *Wells*
E. H. Langston _____ Company
 _____ Contractor

FIRST REPORTS330 Ft. from N. Line

_____ Ft. from S. Line

330 Ft. from E. Line

_____ Ft. from W. Line

SECTION PLAT

			0

Location _____

Rig up _____

Drilling and Remarks:

*R.O.Y.***RECORD**

Cased _____ in., _____ ft.

Sand _____

Gas _____

Oil _____

Total Depth _____

PRODUCTION

1st 24 hrs. Nat. _____

1st 24 hrs. after shot _____

Gas _____ Cu. Ft.

Dry Hole _____

Abandoned _____

Date

MAY 13 1932

CHAS. L. SHERWOOD

192

Scout

Map No. 49 Sec. 4 Twp. 20 R. 9W

Well No. 1-Wells

E. H. Langston Company

Contractor

ABANDONED

330 Ft. from N. Line

Ft. from S. Line

330 Ft. from E. Line

Ft. from W. Line

SECTION PLAT

			0

Location

Rig up

Drilling and Remarks:

RECORD

Cased ft. in., ft.
 Sand silicious 3256
 Gas ---
 Oil ---
 Total Depth 3298

PRODUCTION

1st 24 hrs. Nat. ---
 1st 24 hrs. after shot ---
 Gas --- Cu. Ft.
 Dry Hole ---
 Abandoned ---

Date

8/9/33 192 O. M. Munnick

11/30-	Regd up & SD	
12/7	—	8/9 Top Silicious
12/14	—	3256
12/21	—	T.D. 3298
12/28	—	D. + H. 3298
1/33		ABANDONED
1/4	—	
1/11	—	
1/18	—	
1/25	—	
2/1	—	
2/8	—	
2/15	—	
2/22-	Regd up	
3/4	Regd up & S.D.	
3/8	—	
3/15	—	
3/22	Running 15" - 150'	
3/29	15" - 190 dily 350'	
4/4	- 1060	
4/12	cleaning out 1060'	
4/19	dily 1410'	
4/26	" 1730'	
5/4	S.D. 1750 fad 10'	
5/10	—	
5/17	—	
5/24	run 10" - 1744	
6/1	Dy 1975	
6/8	" 2370'	
6/15	S.D. 2500'	
6/21	—	
6/27	—	
7/5	—	
7/12	dily 2410	
7/19	- 8" 2530 showail 2989 - 95 - 6" 3120'	
	Top K.O. 3115	
7/26	showail 3264 H. 7.10 3277 - 83'	
	Top D. 3298' Top silicious 3256'	
8/2	—	