

KANSAS

FORM 51 5M 4-41 PETROL


Rice

Section 4 Township 20 Range 9-W

Well No. #3 Peterson

Company R. Olsen

NORTH Keesling Pool

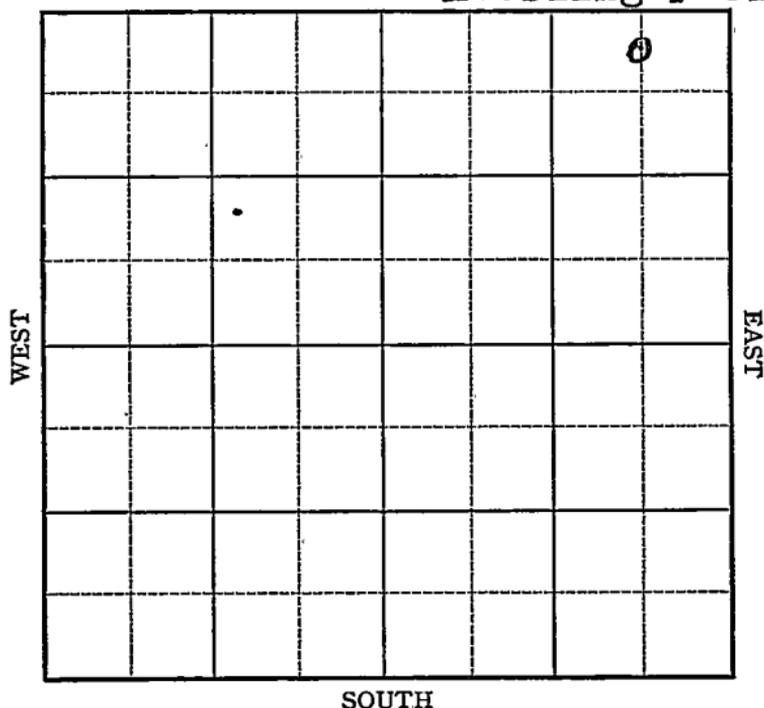

Rice

Map No. 49 Sec. 4 Twp. 20 R. 9W

Well No. 3 Peterson

R. Olsen Company

FIRST REPORT

Contractor

C N L N E N E

SECTION PLAT

330 Ft. from N. Line

_____ Ft. from S. Line

660 Ft. from E. Line

_____ Ft. from W. Line

			o

KEESLING POOL

RECORD

Location _____

Cased _____ in., _____ ft.

Rig up _____

Sand _____

Drilling and Remarks:

Gas _____

Oil _____

Total Depth _____

Surface Hole

PRODUCTION

1st 24 hrs. Nat. _____

1st 24 hrs. after shot _____

Gas _____ Cu. Ft.

Dry Hole _____

Abandoned _____

Date

JUN 17 1942 19

S. J. LEWIS

Scout

Rice

Map No. 49 Sec. 4 Twp. 20 R. 9W

Well No. 3 Peterson

R. Olsen Company

ABANDONED Contractor

C NL NE NE

SECTION PLAT

330 Ft. from N. Line

			o

_____ Ft. from S. Line

660 Ft. from E. Line

_____ Ft. from W. Line

KEESLING POOL

RECORD

Location _____

Cased _____ in., _____ ft.

Rig up _____

Sand _____

Drilling and Remarks:

Gas _____

Core 3237 connected

Oil _____

Total Depth 2246

2000 acid

5" @ 3237

PRODUCTION

1st 24 hrs. Nat. _____

1st 24 hrs. after shot _____

Gas _____ Cu. Ft.

Water

Dry Hole _____

Abandoned _____

Date

JUL 15 1942 19

S. I. LEWIS Scout