

Section 4 Township 20 Range 2W

Well No. #1 C. Unruh

Company Geo. Hess

NORTH

							0

SOUTH

WEST

EAST

McPherson KANSAS

SEC.	TWP.	R.
4	20	2W ✓

WELL NO.

1 C. Unruh

FARM

COMPANY

Geo. Hess

CONTRACTOR

Mallard

Lively Pool

330

Ft. from N. Line


Ft. from S. Line

330

Ft. from E. Line

Ft. from W. Line

NE NE NE

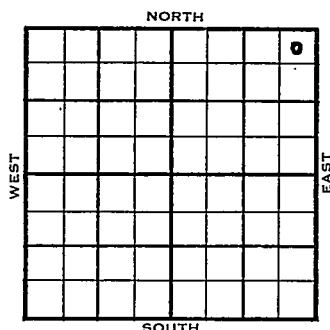

1954

ELEVATION

1540'

REPORT

3/17

Spud 3-14-54
8" @ 157', WOC

3/24

Lans 2327', Miss 1i 2972'
RTD 2974'
5" @ 2972'

3/31

DD 2984'
B/ 65 gw -/ 2 goph 2 hrs. DD

4/7

TD 2991' lot of wtr + SSO

4/14

Spud 3-14-54
D & A
TD 2991'
8" @ 157'
Lans 2327', Miss 2972',
TD 2974'
5" @ 2972'
DD 2984 B/ 65 gw 2 goph 2 hr.
DD 2991' Wtr.
D & A**ABANDONED**

County McPherson State KansasSec. 4 (Blk.) 20 (Sur.) 2W Map No.Operator Geo. HessWell No. 1 Farm C. UnruhElev. Location NE NE NE

330 Ft. From N Line NE330 Ft. From E Line Quarter1st. Report MAR 17 1954

Completion

Remarks

Mallard - Contr.Spudding Date 3-14-54Drig. Data Lively Pool8" @ 157 WOC

County McPherson State KansasSec. 4 (Blk.
Twp.) 20 (Sur.
Rge.) 2W Map No.Operator Geo. HessWell No. 1 Farm C. UnruhElev. 1540 Location NE NE NE

330Ft. From N Line NE330Ft. From E Line Quarter

1st. Report

Completion APR 14 1954Remarks Lively PoolMallard - Contr.Spudding Date 3-14-54Drig. Data D & A TD 29918" @ 157 Lans. 2327 Miss. 2972TD 2974 5" @ 2972 DD 2984 B/ 65 gw2 goph 2 hr. DD 2991 wtrD & A

J. G. McGENEE