


Section 4 Township 20 Range 4WWell No. #1 SittsCompany Anschutz Drlg.

NORTH

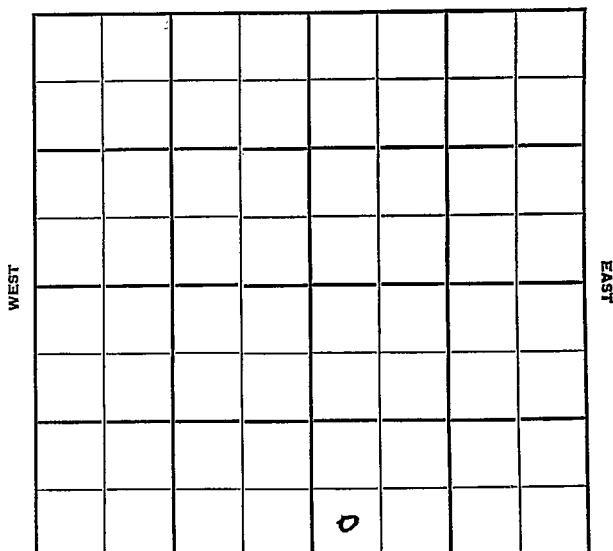

SOUTH

McPherson

KANSAS ✓

Sec. 4 Twp. 20 R. 1W

Well No. #1 Sitts Farm

Anschutz Drlg.

Company

Honaker Drlg.

Contractor

Wildcat

Ft. from N. Line

330

Ft. from S. Line


Ft. from E. Line

330

Ft. from W. Line

SW-SW SE

Phillips DHM

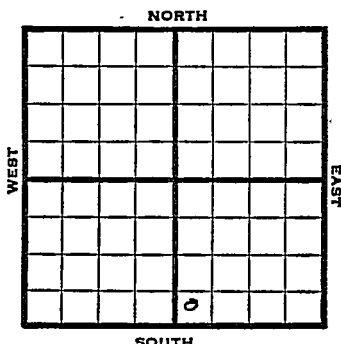

1952

Elev. 1485' REPORT

9/4 Gellar & Pits

9/10 8" @ 248

9/17 Lans. 2593'
Drlg. 3302'

Miss Li 3245

9/24 Spud 9-6-52
D&A TD 3905'
8" @ 248'

Lans. 2593

Miss. 3245

Kh. 3524

Viola 3780

Simp. sh. 3811

Simp. sd 3816

Arb. 3885

TD 3905' D&A

ABANDONED

J. G. McGEHEE

J. G. McGEHEE