


Section 4 Township 20 Range 1W

Well No. #1 V ogt

Company Levitte & Mason

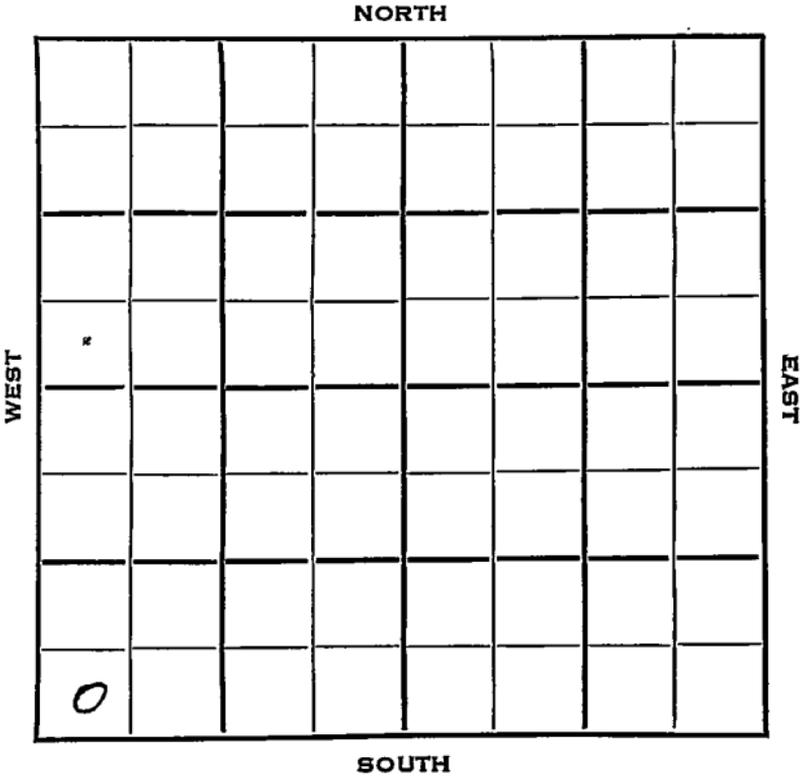

McPherson

KANSAS ✓

Sec. 4 Twp. 20 R. 1 W

Well No. # 1 Vogt Farm

Levitt & Mason Company

Pabco Drlg. Contractor

Wildcat


_____ Ft. from N. Line

330 Ft. from S. Line

_____ Ft. from E. Line

330 Ft. from W. Line

SW SW SW

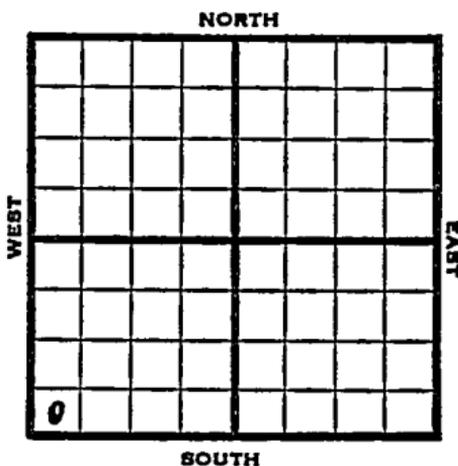

1953

Elev. 1565' REPORT

8/19

MIR

8/26

8" @ 163 Miss 2932'
Drlg. 2990'

9/2

DST 2934-90 1 hr, 2½ M gas,
DST 2970-90 ½ hr, 1,630,000 gas
55' gcm, 760#
DST 2995-3011 1 hr, 95' SO&GCM, 720#
KH 3213, V 3435-38
RTD
DST 3434-38 1 hr, 430' Oil, 340' Wtr.
910#.

9/9

5" @ 3436'

9/16

CO 3438
FU O&W
PB 2980
30/2965-70, 3-2/3 M Gas

9/23

Shut in

9/30

Spud 8-19-53 Gas well TD 3438'
8" @ 16A Cong. 2927 Miss 2932
DST 2934-90 open 1 hr rec 2½ MCFG
DST 2970-90 open ½ hr rec 1,630,000
gas, 55' GCM 760#
DST 2995-3011 open 1 hr rec 95' SO
& GCM. 720# Kh. 3213 Viola 3435
TD 3438

OVER

1953

9/30

(Information continued)

DST 3434-38 open 1 hr, rec 430'
oil, 340' wtr. 910# 5" @ 3436

CO to 3438 FU oil & wtr.

PB 2980 30/2965-70

Comp. shut in gas well ~~XXXXXX~~

3-2/3 MCFGPD

COMPLETED

County McPherson State Kansas
 Sec. 4 (Blk. 20) (Sur. 1W) (Twp.) (Rge.) Map No.
 Operator Levitt & Mason
 Well No. 1 Farm Vogt
 Elev. 1565 Location SW SW SW

0					

330 Ft. From S Line SW
330 Ft. From W Line Quarter

Ist. Report

Completion SEP 30 1953

Remarks Wildcat
Pabco Drlg. - Contr.

Spudding Date 8-19-53

Drlg. Data Gas well TD 3438
8" @ 163 Cong. 2927 Miss. 2932
DST 2934-90 open 1 hr. Rec. 2 $\frac{1}{2}$ mcfg
DST 2970-90 open $\frac{1}{2}$ hr. rec. 1,630,000
gas 55' gcm 760# DST 2995-3011
open 1 hr. Rec. 95' so & gcm 720#
Kh. 3213 Viola 3435 TD 3438 - DST 3434-
38 open 1 hr. Rec. 430' oil 340' wtr.
910# 5" @ 3436 CO to 3438 FU oil &
wtr. PB 2980 30/ 2965-70
Comp. shut in gas well 3 $\frac{2}{3}$ mcfgpd