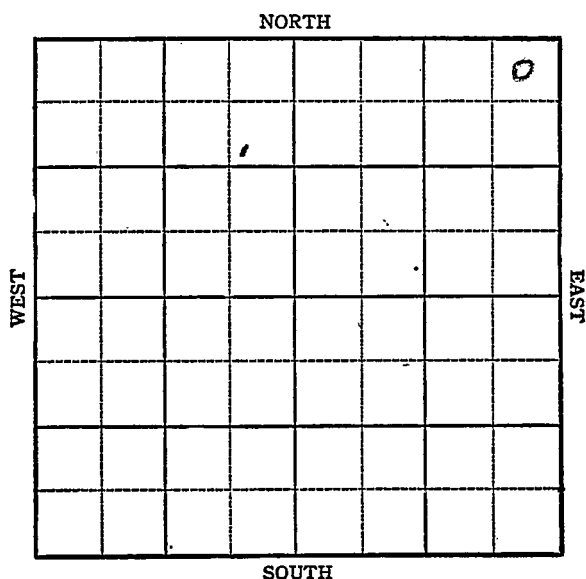


KANSAS

McPherson

FORM 51 5M BRIX

Section 4 Township 20 Range 1WWell No. #1, VogtsCompany Phillips

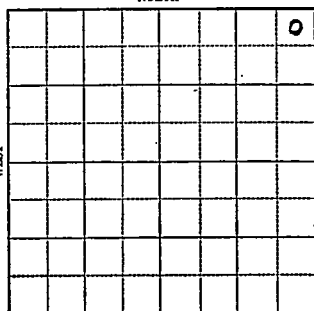
KANSAS

McPherson County

Sec. 4 Twp. 20 R. 1WWell No. 1 Vogts FarmPhillips Company

Ritz-Canton

NORTH

330 Ft. from N. Line Ft. from S. Line330 Ft. from E. Line Ft. from W. LineElev. 1569

SOUTH

1944

R E P O R T

7/5

Loc.

7/12

8" @ 127

Drlg 1060

7/19

Lans 2354

Drlg 2800

7/26

Miss 2930

3054 fishing.

8/2

Drlg. 3093

8/9

Vioha 3436

Simp 3465

Drlg. 3540

8/16

Arb 3543

TD 3572

ABANDONED

Pool Name Ritz-Canton

KANSAS

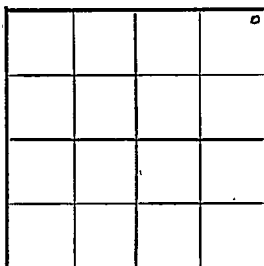
Map No. 43 Sec. 4 Twp. 20 R. 1WWell No. 1 VogtsPhillips Company

FIRST REPORT

Contractor

NE/C

SECTION PLAT

330 Ft. from N. Line Ft. from S. Line330 Ft. from E. Line Ft. from W. Line

McPherson County

Location XRig up

Drilling and Remarks:

RECORD

Cased in., ft.Sand Gas Oil Total Depth

PRODUCTION

1st 24 hrs. Nat. 1st 24 hrs. after shot Gas Cu. Ft.Dry Hole Abandoned

Date

JUL 5 1944 19 S. J. LEWIS Scout

KANSAS Pool Name Ritz-Canton
 Map No. 23 Sec. 4 Twp. 20 R. 1W
 Well No. 1 Vogts

Phillips Company
ABANDONED Contractor

NE/C

SECTION PLAT

330 Ft. from N. Line Ft. from S. Line330 Ft. from E. Line Ft. from W. Line

			4

McPhersonLocation Rig up

Drilling and Remarks:

Ce x 3543

RECORD

Cased in., ft.Sand Gas Oil Total Depth 3572

PRODUCTION

1st 24 hrs. Nat. 1st 24 hrs. after shot Gas Cu. Ft.Dry Hole Abandoned

Date

AUG 16 1944

19

S. J. LEWIS Scout