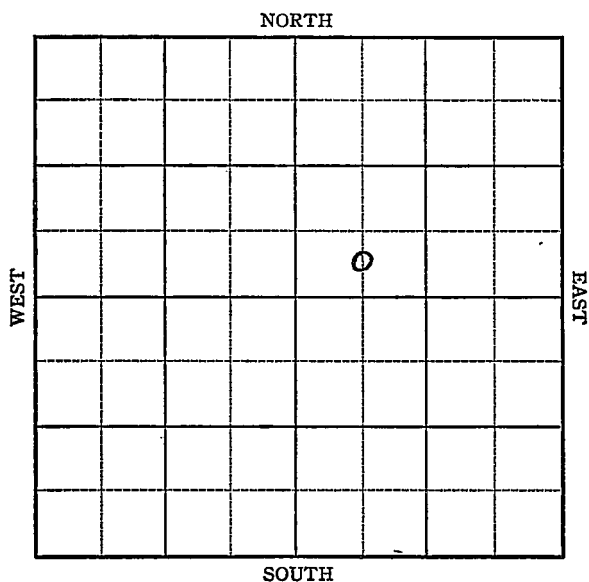


Rice

KANSAS

Section 4 Township 20 Range 9-WWell No. #1 PetersonCompany K. Olson

KANSAS


Rice

Sec. 4 Twp. 20 R. 9-WWell No. #1 Peterson FarmR. Olsen Company

(Keesling)

 Ft. from N. Line330 Ft. from S. Line Ft. from E. Line660 Ft. from W. Line

Elev. 1698

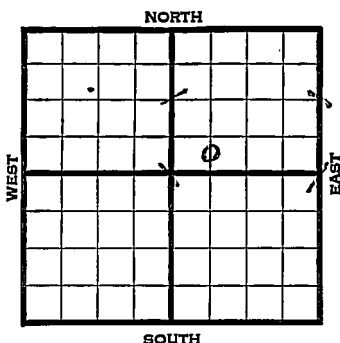

1941	REPORT
11/25	Drl g. 100'
12/4	" "
12/11	12" @ 176 WOC
12/18	" "
12/24	" "
12/31	Drl g. 780'
1942	
1/8	SD 780'
1/15	"
1/22	"
1/29	"
2/5	Drlg. 1100'
2/12	Drlg. 2380'
2/19	Drlg. 3181'
2/26	Arb. 3244' T.D. 3247'
	7" - 3244' RUST.
3/5	800' oil, No time.
3/12	Swab 464 oil 24 hours.
3/19	500 acid. 3000' oil.
3/26	" " "
4/2	Shut down.
4/8	" "

OVER

1942
4/15

Arb. 3244'

7" - 3244'

T.D. 3247'

500 acid.

Potential 555 bbls., pump.

44.5 Gravity


COMPLETED

Rice

KANSASMap No. H-49 Sec. 4 Twp. 20 R. 9WWell No. 1 PetersonR. Olsen Company**FIRST REPORT**

Contractor

C SL SW NE

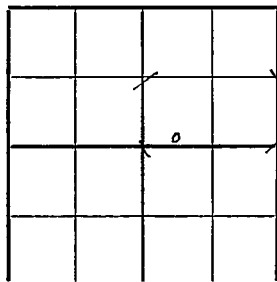SECTION PLAT Ft. from N. Line330 Ft. from S. Line Ft. from E. Line660 Ft. from W. Line**KEESLING POOL****RECORD**Location Cased in., ft.Rig up Sand Drilling and Remarks: Gas Oil

Drilg. 100'

Total Depth **PRODUCTION**1st 24 hrs. Nat. 1st 24 hrs. after shot Gas Cu. Ft.Dry Hole Abandoned

Date

NOV 25 1941 19S. J. LEWIS Scout

KANSASMap No. 49 Rice Sec. 4 Twp. 20 R. 9WWell No. 1 PetersonR. Olsen Company**COMPLETED** Contractor

C SL SW NE

 Ft. from N. Line330 Ft. from S. Line Ft. from E. Line660 Ft. from W. Line

SECTION PLAT

KEESLING POOL

Location Rig up

Drilling and Remarks:

Ar 83244
2" 83244
500 and
Pump 555 P.D.

445/92

RECORD

Cased in., ft.Sand Gas Oil Total Depth 8247

PRODUCTION

1st 24-hrs. Nat. 1st 24 hrs. after shot Gas Cu. Ft.Dry Hole Abandoned

Date

APR 15 1942

19

S. J. LEWIS Scout