


Rice

Section 4 Township 20 Range 9-W

Well No. #2 Peterson

Company Luther Mackall

NORTH Keesling Pool

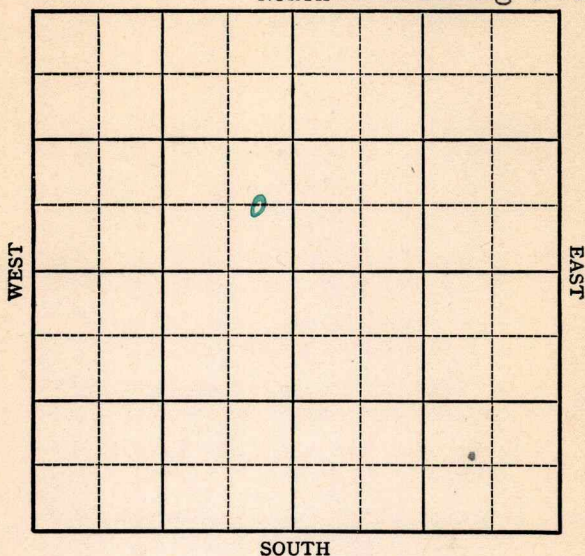

Map No. 49 Sec. 4 Twp. 20 R. 9WWell No. 2 Peterson (was Hinkle)
Luther Mackall Company

FIRST REPORT

Contractor

C EL SE NW

SECTION PLAT

		o	

_____ Ft. from N. Line

660 Ft. from S. Line330 Ft. from E. Line

_____ Ft. from W. Line

KEESLING POOL

RECORD

Location _____

Cased _____ in., _____ ft.

Rig up _____

Sand _____

Drilling and Remarks:

Gas _____

Oil _____

Rotary

Total Depth _____

PRODUCTION

1st 24 hrs. Nat. _____

1st 24 hrs. after shot _____

Gas _____ Cu. Ft.

Dry Hole _____

Abandoned _____

Date

APR 15 1942 19S. J. LEWIS Scout

Rice

Map No. 49 Sec. 4 Twp. 20 R. 9WWell No. 2 PetersonLuther Mackall CompanyABANDONED Contractor

C E L S E N W

SECTION PLAT

 Ft. from N. Line660 Ft. from S. Line330 Ft. from E. Line Ft. from W. LineKEESLING POOL

RECORD

Location Cased in., ft.Rig up Sand

Drilling and Remarks:

Gas Oil Total Depth 3267Lane 2899CR 43262 1/45" @ 3264Water

PRODUCTION

1st 24 hrs. Nat. 1st 24 hrs. after shot Gas Cu. Ft.Dry Hole Abandoned

Date

MAY 27 1942

19

S. J. LEWIS Scout