

KANSAS

Rice county

Section 5 Township 20 Range 9-WWell No. #1, GoffmanCompany C. V. Bay Company

NORTH

SOUTH

WEST

EAST

0

KANSAS

Rice County ✓

Sec. 5 Twp. 20 R. 9W

Well No. #1 Coffman Farm

C. V. Bay Company


Chase

 Ft. from N. Line

330 Ft. from S. Line

330 Ft. from E. Line

 Ft. from W. Line

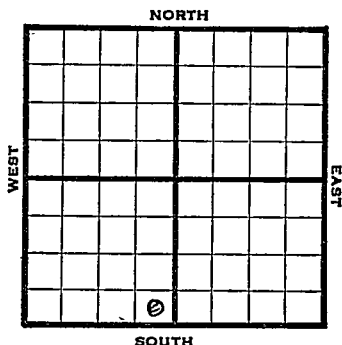

SE SW

1946 Elev. 1720' REPORT

8/28 8" @ 212'
220'
9/5 Drlg 2945'
9/18 Lans 2895
Cong 3216'
TD 3 263'
500 acid HFW PB
9/24 30 shots 3083 to 3088-500 acid
Swb 20 gal oil plus 5 bbl W
PH 2 hrs.
10/2 Arb 3248'
5" @ 3248'
TD 3264'

ABANDONED

KANSAS

Kansas Pool Name Chase

Map No. 49 Sec. 5 Twp. 20 R. 9W

Well No. 1 Coffman

C. V. Bay Company

FIRST REPORT

Contractor

SE SW


SECTION PLAT

 Ft. from N. Line

330 Ft. from S. Line

330 Ft. from E. Line

 Ft. from W. Line

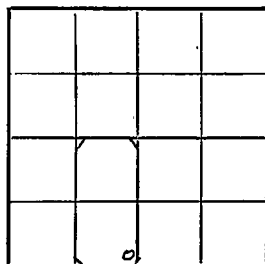

Rice County

Location

Rig up

Drilling and Remarks:

8" @ 212'

220'

RECORD

Cased in., ft.

Sand

Gas

Oil

Total Depth

PRODUCTION

1st 24 hrs. Nat.

1st 24 hrs. after shot

Gas Cu. Ft.

Dry Hole

Abandoned

Date

AUG 28 1946 19

S. J. LEWIS

Scout

KANSAS

Kansas

Pool Name Chase Pool

Map No. 49 Sec. 5 Twp. 20 R. 9W

Well No. 1 Coffman

C. U. Bay

Company

ABANDONED

Contractor

SE SW

E1, 1720

SECTION PLAT

Ft. from N. Line

330 Ft. from S. Line

330 Ft. from E. Line

Ft. from W. Line

Rice County

Location

Rig up

Drilling and Remarks:

Cr 43248
5" 43248.

RECORD

Cased in, ft.

Sand

Gas

Oil

Total Depth 3263

PRODUCTION

1st 24 hrs. Nat.

1st 24 hrs. after shot

Gas Cu. Ft.

Dry Hole

Abandoned

Date

OCT 2 1946 19

S. J. LEWIS

Scout