


Map No. KANSAS Sec. 5 Twp. 20 R. Rice

Well No. 1 Coffman Farm
Supply Oil Company

NORTH

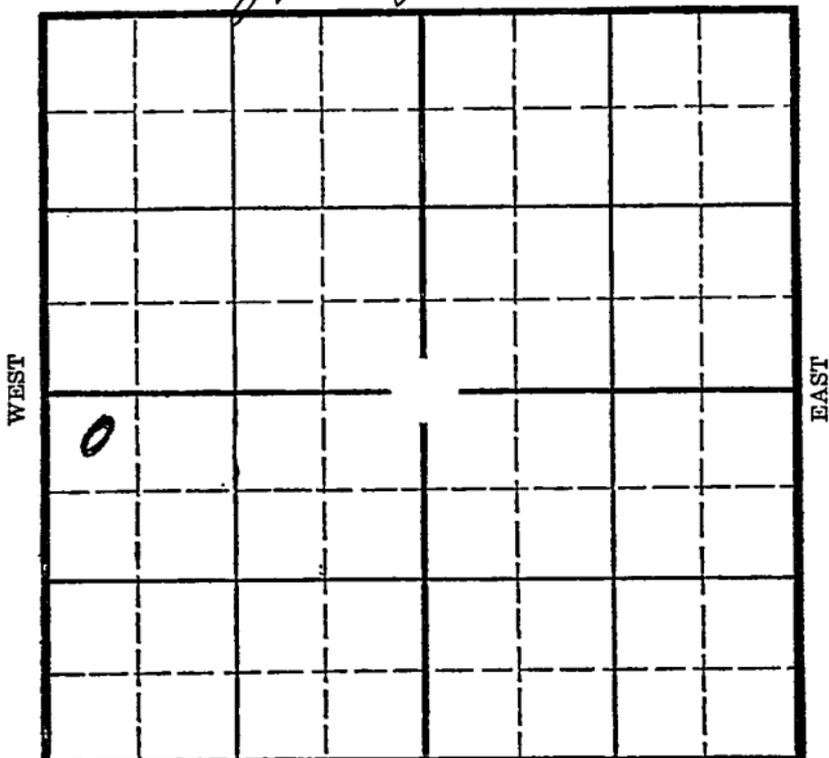

Location _____
Drilling Remarks _____

RECORD

Cased _____ in. _____ ft.

Sand _____

Gas _____

Oil _____

Total Depth _____

Rig Up _____
Drilling Remarks _____

PRODUCTION

1st 24 hrs. Nat. _____

1st 24 hrs. after shot _____

Gas _____ cu. ft. _____

Dry Hole _____

Abandoned _____

Rice
9W

Map No. KANSAS Sec. 5 Twp. 20 R. 9W

Well No. 1- Coffman Farm
Hypsey Oil Company


330 Ft. from N. Line

Ft. from S. Line

Ft. from E. Line

330 Ft. from W. Line

Elev. 1722

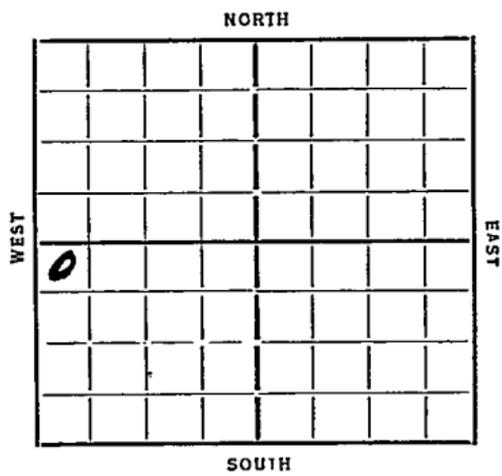

Date 1935 REPORT

7/2 Location
7/11 April
7/18 dly 2780
8/1 Oil 3238 7" 3240
 at 3247 2600' Oil
 Swab 340 11 hrs.
8/8 395 Oil 136 W 24 hrs.
8/15 1000 acid
 721 Oil 300 W.
8/21 Oil 3238
 T-7 3247
 721 Oil
 300 Wto.

COMPLETED

Map No. 49 Sec. 5 Twp. 20 R. 9W

Well No. 1 - Coffman

hussy oil Company

Contractor

FIRST REPORTS

SECTION PLAT

330 Ft. from N. Line

..... Ft. from S. Line

..... Ft. from E. Line

330 Ft. from W. Line

Location

Rig up.....

Drilling and Remarks:

RECORD

Cased.....in.,ft.

Sand.....

Gas.....

Oil.....

Total Depth.....

PRODUCTION

1st 24 hrs. Nat.....

1st 24 hrs. after shot.....

Gas.....Cu. Ft.

Dry Hole.....

Abandoned.....

Date

7-7-35 192.....

W. M. J. HICK
Scout

Map No. 49 Sec. 5 Twp. 20 R. 9W

Well No. 1-Coffman

Myssy oil Company

Contractor

COMPLETED

SECTION PLAT

330 Ft. from N. Line

..... Ft. from S. Line

..... Ft. from E. Line

330 Ft. from W. Line

0			

Location.....

Rig up.....

Drilling and Remarks:

*721 oil
300 water*

RECORD

Cased..... in., ft.

Sand oil 3238

Gas.....

Oil.....

Total Depth 3247

PRODUCTION

1st 24 hrs. Nat.....

1st 24 hrs. after shot.....

Gas..... Cu. Ft.

Dry Hole.....

Abandoned.....

Date

ORVAL MANNSCHECK

8-21-35 192.....

Scout