


Rice

Section 5 Township 20 Range 9-W

Well No. 1 Kirkendall

Company Gulf

NORTH North Coldwater Pod

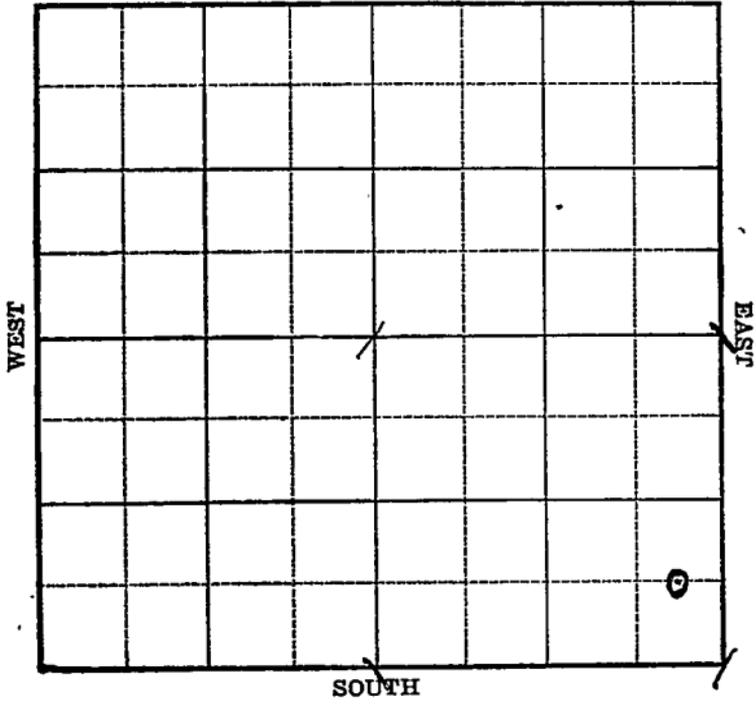

KANSAS

Rice

Sec. 5 Twp. 20 R. 9-W

Well No. #1 Kirkendall Farm

Gulf

Company

(North Coldwater)


_____ Ft. from N. Line

660 Ft. from S. Line

330 Ft. from E. Line

_____ Ft. from W. Line

Elev. 1721

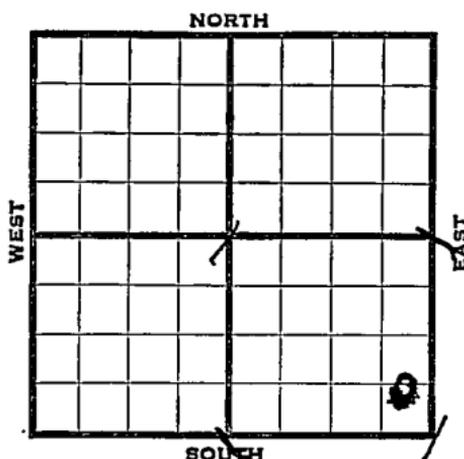

1939	REPORT
4/26	R. R.
5/5	8-5/8" - 201' Drlg. 1400'
5/12	Drlg. 2197'
5/19	Lans. 2927' SSO 3020-28' Drlg. 3050'
5/26	Arb. 3249' 5" - 3253' T.D. 3256' RUST. S. O.
6/7	" " " " "
6/8	T.D. 3267'. 500 acid 6l oil 8 hrs. T.D. 3272' swab 48 bbls 6 1/2 hrs.
6/14	Arb. 3249' 5" - 3253' T.D. 3272' 500 acid. Pump 194.48 bbls. 8 hours. Potential 583 bbls.
	COMPLETED

Rice

Map No. 49 Sec. 5 Twp. 20 R. 9WWell No. 1 KirkendallGulf Company

Contractor

FIRST REPORT

C E L S E S E

SECTION PLAT

_____ Ft. from N. Line

660 Ft. from S. Line330 Ft. from E. Line

_____ Ft. from W. Line

NORTH COLDWATER POOL

Location _____

Rig up _____

Drilling and Remarks:

RR

RECORD

Cased _____ in., _____ ft.

Sand _____

Gas _____

Oil _____

Total Depth _____

PRODUCTION

1st 24 hrs. Nat. _____

1st 24 hrs. after shot _____

Gas _____ Cu. Ft.

Dry Hole _____

Abandoned _____

Date

APR 26 1939 19 H. D. Hatfield Scout

Map No. 49 Sec. 5 Twp. 20 R. 9W

Well No. 1 Kirkendall

Gulf Company

Contractor

COMPLETED

C E L S E S E

SECTION PLAT

_____ Ft. from N. Line

660 Ft. from S. Line

330 Ft. from E. Line

_____ Ft. from W. Line

NORTH COLDWATER POOL

Location _____

Rig up _____

Drilling and Remarks:

*Or 8249
5" @ 2253
500 acid
Pump 194.48-8 lbs
P 8 583*

RECORD

Cased _____ in., _____ ft.

Sand _____

Gas _____

Oil _____

Total Depth 3272

PRODUCTION

1st 24 hrs. Nat. _____

1st 24 hrs. after shot _____

Gas _____ Cu. Ft.

Dry Hole _____

Abandoned _____

Date

JUN 14 1939 19

S. J. LEWIS Scout