


KANSAS Rice

FORM 51 5M 11-44 PETROL

Section 5 Township 20 Range 9-W

Well No. #1 Kirkendall "B"

Company Chalmette Pet.

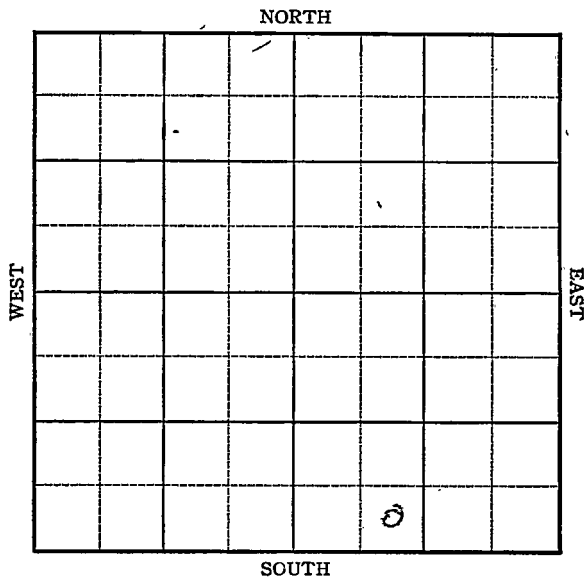

KANSAS

Rice County

Sec. 5 Twp. 20 R. 9W

Well No. #1 Kirkendall "B" Farm

Chalmette Pet. Company

Silica


Ft. from N. Line

330 Ft. from S. Line

Ft. from E. Line

990 Ft. from W. Line

SE SW SE

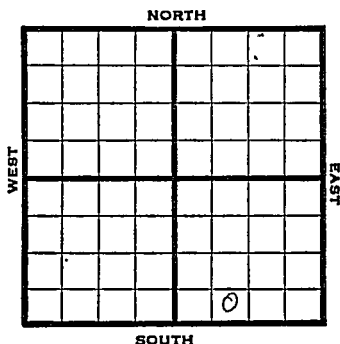

1946 Elev. 1723' REPORT

1/23 8" @ 203'
WOC
All but SE 10 acres
1/31 Drlg. 2577'
2/7 Lans. 2900' Arb. 3228-30' T.D.
5" - 3229' RUST.
2/14 " " "
2/21 " " "
2/28 " " "
3/7 Swab 10 oil per hour 2 hours.
3/14 " " "
3/21 " " "
3/28 " " "
4/4 " " "
4/10 " " "
4/16 " " "
4/23 " " "
5/1 Arb. 3228
5" @ 3229
TD 3231'
500 acid.
Pump 135 Pot.
Grav. 42.6

COMPLETED

KANSAS

Kansas Pool Name SilicaMap No. 49 Sec. 5 Twp. 20 R. 9WWell No. 1 Kirkendall "B"Chalmette Pet.


Company

FIRST REPORT

Contractor

SE SW SE

SECTION PLAT

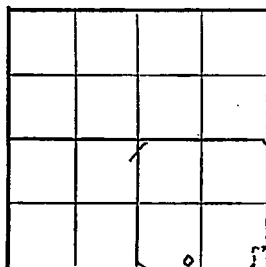

Ft. from N. Line

330

Ft. from S. Line

Ft. from E. Line

990

Ft. from W. Line

Rice County

Location

Rig up

Drilling and Remarks:

8"-203 WOE

all but se 10
area

RECORD

Cased _____ in., _____ ft.

Sand _____

Gas _____

Oil _____

Total Depth _____

PRODUCTION

1st 24 hrs. Nat. _____

1st 24 hrs. after shot _____

Gas _____ Cu. Ft.

Dry Hole _____

Abandoned _____

Date

JAN 23 1946

19

S. J. LEWIS

Scout

KANSAS Kansas Pool Name Silica
 Map No. 49 Sec. 5 Twp. 20 R. 9W
 Well No. 1 Kirkendall "B"

Chalmette Pet.

Company

COMPLETED

Contractor


SE SW SE

E 11723
SECTION PLAT

_____ Ft. from N. Line

330 Ft. from S. Line

_____ Ft. from E. Line

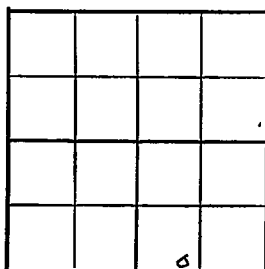990 Ft. from W. Line
**Rice County**

Location _____

Rig up _____

Drilling and Remarks:

Per X 32285" C 3229500 acidPump 135042 6 Ge**RECORD**

Cased _____ in., _____ ft.

Sand _____

Gas _____

Oil _____

Total Depth 3231**PRODUCTION**

1st 24 hrs. Nat. _____

1st 24 hrs. after shot _____

Gas _____ Cu. Ft.

Dry Hole 714

Abandoned _____

Date

MAY 1 1945 19

S. J. LEWIS Scout