



Rice

Form 252-A  
5M 4-32 MPC

Map No. **KANSAS** Sec. 5 Twp 20 R. 9W

Well No. 1 Proffett Farm


~~W.A.~~ Mid-Kansas Company

330' Ft. from N. Line

\_\_\_\_\_ Ft. from S. Line

\_\_\_\_\_ Ft. from E. Line

330' Ft. from W. Line

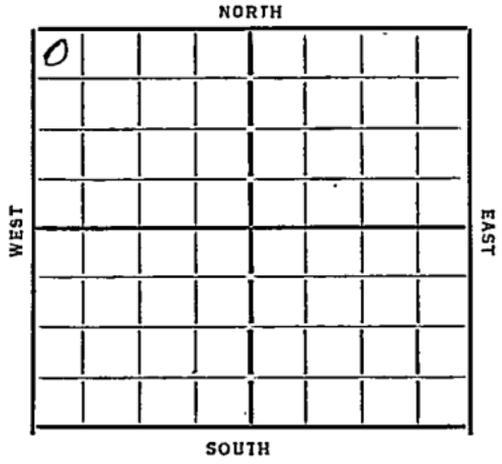

Date 1/23

REPORT

8/23 Location

8/30 Bldg Rig

9/6

9/13 Rig up

9/20 20" - 80'

9/29 Hreg 400

10/5 " 1650'

10/11 10" at 2217

10/18 10" at 2222 - Hreg 2732

10/25 8" 2958 - oil 2970 - oil also  
3022 - 26" Hreg 3135

11/1 Top Sib 3213 T.D. 3218 1/2  
6" at 3213 H.F. Oil.

11/8 Swab 220 bbls in 3 hrs  
Run rods.

4/15 Seal case 3213 T.D. 3218 1/2  
1089 Bbls

COMPLETED

Map No. 49 Sec. 5 Twp. 20 R. 9W

Well No. 1- Proppitt

M-K Company

Contractor

SECTION PLAT

330 Ft. from N. Line

..... Ft. from S. Line

~~330~~ Ft. from E. Line

330 Ft. from W. Line

○			✱

FIRST REPORTS

Location

Rig up .....

Drilling and Remarks:

*[Faded handwritten notes and diagrams, possibly showing well layout or measurements]*

RECORD

Cased.....in., .....ft.

Sand.....

Gas.....

Oil.....

Total Depth.....

PRODUCTION

1st 24 hrs. Nat.....

1st 24 hrs. after shot.....

Gas.....Cu. Ft.

Dry Hole.....

Abandoned.....

Date

8/23/33 192 C. Mannschreck Scout

Map No. 49 Sec. 5 Twp. 20 R. 9W

Well No. 1- proppitt

Mid-Kansas Company

Contractor

SECTION PLAT

330 Ft. from N. Line

..... Ft. from S. Line

330 Ft. from E. Line

..... Ft. from W. Line

0			

**COMPLETED**

Location.....

Rig up.....

Drilling and Remarks:

1089 bbls

RECORD

Cased..... in., ..... ft.

Sand siliceous 3213

Gas.....

Oil.....

Total Depth 3218 1/2

PRODUCTION

1st 24 hrs. Nat.....

1st 24 hrs. after shot.....

Gas..... Cu. Ft.

Dry Hole.....

Abandoned.....

Date

11-15-33 192

Omanuscheck Scout