


Rice

Map No. _____ Sec. 5 Twp. 20 R. 940Well No. 2 Proffitt Farm _____Mid-Kansas Company _____

NORTH

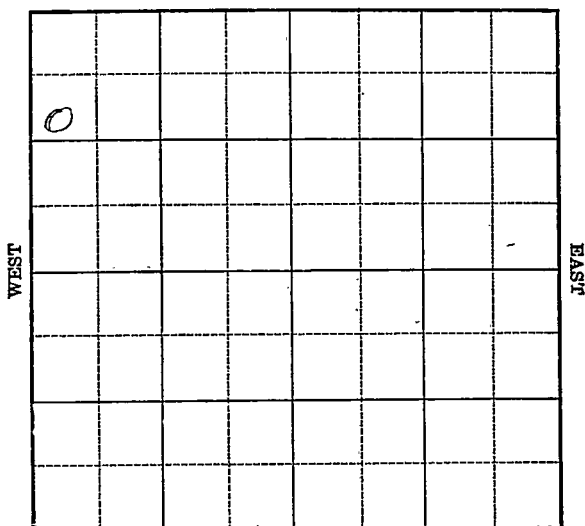

SOUTH

Location _____
Drilling Remarks _____Rig Up _____
Drilling Remarks _____

RECORD

Cased _____ in. _____ ft.

Sand _____

Gas _____

Oil _____

Total Depth _____

PRODUCTION

1st 24 hrs. Nat. _____

1st 24 hrs. after shot _____

Gas _____ cu. ft. _____

Dry Hole _____

Abandoned _____

Rice

Map No. KANSAS Sec. 5 Twp. 20 R. 940

Well No. 2 Proffitt Farm


Mid-Kansas Company

990 Ft. from N. Line

_____ Ft. from S. Line

_____ Ft. from E. Line

330 Ft. from W. Line

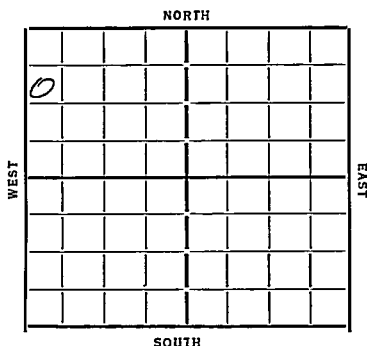

Date 12/33

REPORT

12/6 Bldg Rig
12/13 Run up
12/27 Drilg 1245 20" 193
1/4 10" at 2227 - (12" 1529)
1/11 Drilg 2605
1/17 8" at 2830
Show oil 2980-85
K.C. Line 2905
Drilg 2995
1/24 Siliceous 3231 T.D. 3237
H.F.O. in 3 hrs - run tubing
1/31 Siliceous 3231 T.D. 3237 Pump
823 Bbl 21 hrs.

COMPLETED

Map No. 49 Sec. 5 Twp. 20 R. 9WWell No. 2 - ProppittMid-Kansas Company

Contractor

FIRST REPORTS

990 Ft. from N. Line

Ft. from S. Line

Ft. from E. Line

330 Ft. from W. Line

SECTION PLAT

0			

Location

Rig up

Drilling and Remarks:

BR

RECORD

Cased in., ft.

Sand

Gas

Oil

Total Depth

PRODUCTION

1st 24 hrs. Nat.

1st 24 hrs. after shot

Gas Cu. Ft.

Dry Hole

Abandoned

Date

12-6-33 192O. Manscheck Sec 601

Map No. 49 Sec. 5 Twp. 20 R. 9WWell No. 2-ProppittMid-Kansas Company

Contractor

COMPLETED990 Ft. from N. Line

Ft. from S. Line

Ft. from E. Line

330 Ft. from W. Line

SECTION PLAT

0			

Location

Rig up

Drilling and Remarks:

RECORD

Cased in, ft.

Sand silicious 3231

Gas

Oil

Total Depth 3237

PRODUCTION

1st 24 hrs. Nat.

1st 24 hrs. after shot

Gas Cu. Ft.

Dry Hole

Abandoned

Ramp 823 hbls
21 hrs.

Date

1-31-34 192 O. Mannschreck Scout