


Map No. **KANSAS**Sec. **5** Twp. **20** R. **9W**Well No. **46-Profitt** Farm
Marathon Oil Company

NORTH

WEST

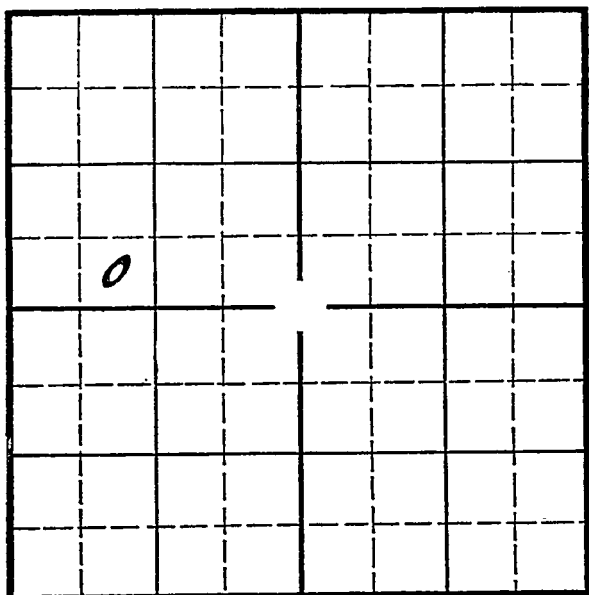

EAST

SOUTH

Location
Drilling RemarksRig Up
Drilling Remarks

RECORD

Cased _____ in. _____ ft.

Sand _____

Gas _____

Oil _____

Total Depth _____

PRODUCTION

1st 24 hrs. Nat. _____

1st 24 hrs. after shot _____

Gas _____ cu. ft. _____

Dry Hole _____

Abandoned _____

KANSAS

Map No. _____ Sec. 5 Twp. 20 R. 9W

Well No. 6- Proffitt Farm _____

Marathon Oil

Company


_____ Ft. from N. Line

330 Ft. from S. Line

_____ Ft. from E. Line

990 Ft. from W. Line

Elev. 1727

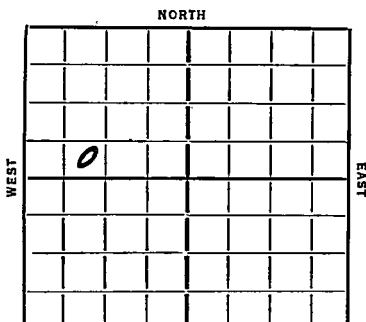

REPORT

Date 1935
10/2 Bldg Rig
10/19 Rgn
11/7 Alg 2005 12" 1648
11/7 " 2500
11/14 TD 2870 W 8"
11/21 6" 3224 Lil 3234
11/27 AV 3236
11/27 Lil 3234
TD 3245
1027 Bldg.

COMPLETED

KANSAS

Map No. 49 Sec. 5 Twp. 20 R. 9WWell No. 6-ProffittMarathon oil Company

Contractor

FIRST REPORTS

SECTION PLAT

0			

Ft. from N. Line

330 Ft. from S. Line

Ft. from E. Line

990 Ft. from W. Line

Location

Rig up

Drilling and Remarks:

Blag Rig

RECORD

Cased.....in., ...ft.

Sand.....

Gas.....

Oil.....

Total Depth.....

PRODUCTION

1st 24 hrs. Nat.....

1st 24 hrs. after shot.....

Gas.....Cu. Ft.

Dry Hole.....

Abandoned.....

Date

ORVAL MANNSCHRECK

10-7-35 192

Scout

Map No. 49 Sec. 5 Twp. 20 R. 9Well No. 6-1 ProffittMarathon Oil Company

Contractor

COMPLETE

SECTION PLAT

0			

Ft. from N. Line

330 Ft. from S. Line

Ft. from E. Line

990 Ft. from W. Line

Location

Rig up

Drilling and Remarks:

1027 bbl

RECORD

Cased in ft.

Sand Oil 3234

Gas

Oil 3245Total Depth 7027

PRODUCTION

1st 24 hrs. Nat.

1st 24 hrs. after shot

Gas Cu. Ft.

Dry Hole

Abandoned

Date

11-27-35 192

ORVAL MANNSCHWEL Scout