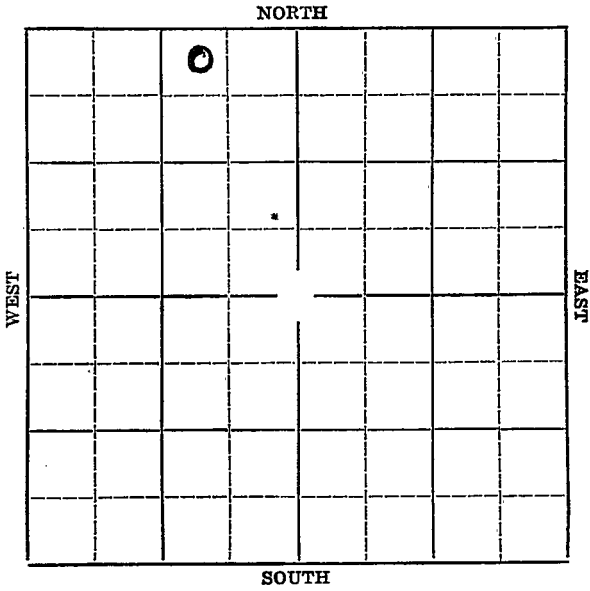


Rice

KANSAS

Form 51—5M—4-36—Palace

Section 5 Township 20 Range 9-WWell Number 10 ProffittCompany Ohio Oil

1937

6/30

Sil. 3228'.

T.D. 3242' S.W.

P.B. 3240'.

1000 A.

Pot. 296 bbls.

COMPLETED

KANSAS*Rice*Map No. _____ Sec. 5 Twp. 20 R. 9W.Well No. 10 ProffittOhio Oil Company_____
Contractor**SECTION PLAT**

	2		

330 Ft. from N. Line

____ Ft. from S. Line

880 Ft. from E. Line

____ Ft. from W. Line

FIRST REPORT

Location _____

Rig up _____

Drilling and Remarks:

*Rig***RECORD**

Cased _____ in., _____ ft.

Sand _____

Gas _____

Oil _____

Total Depth _____

PRODUCTION

1st 24 hrs. Nat. _____

1st 24 hrs. after shot _____

Gas _____ Cu. Ft.

Dry Hole _____

Abandoned _____

Date

APR 21 1937 19

S. J. LEWIS Scout

Rice KANSAS

Map No. 49 Sec. 5 Twp. 20 R. 9 WWell No. 10 - ProffittOhio Company

Contractor

COMPLETED**SECTION PLAT**

	0		

330 Ft. from N. Line

_____ Ft. from S. Line

880 Ft. from E. Line

_____ Ft. from W. Line

Location _____

Rig up _____

Drilling and Remarks:

P.B. 32401000 A.Pat - 296**RECORD**

Cased _____ in., _____ ft.

~~Sand~~ 511 3228

Gas _____

Oil _____

Total Depth 3242 - S.W.**PRODUCTION**

1st 24 hrs. Nat. _____

1st 24 hrs. after shot _____

Gas _____ Cu. Ft.

Dry Hole _____

Abandoned _____

Date

JUN 30 1937 19H. D. Hatfield

Scout