

KANSAS

Rice

Section 5 Township 20 Range 9W

Well No. 12 Proffitt

Company Ohio Oil

Chase Pool

NORTH

			D				

WEST

EAST

SOUTH

KANSAS

Rice

Sec. 5 Twp. 20 R. 9W ✓

Well No. #12 Proffitt Farm

Ohio Oil Company

Chase Pool


990' Ft. from N. Line

\_\_\_\_\_ Ft. from S. Line

330' Ft. from E. Line

\_\_\_\_\_ Ft. from W. Line

SE NE NW

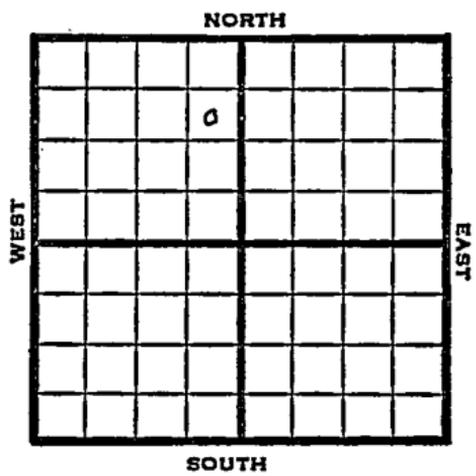

1948

Eli 1719'

REPORT

11/23 Surface Hole

11/30 8" @ 222'

Drlg 2508'

12/6 Lansing 2897'

Arbuckle 3220'

TD 3222'

7" @ 3221'

12/15 TD 3222'

Arb. 3220'

7" @ 3221'

Pump 50 Oil Pot

42° Gr.

Comp. rection

**COMPLETED**

Returned for

in Location

12/1/48

Map No. \_\_\_\_\_ Sec. 5 Twp. 20 R. 9W

Well No. 12 Proffitt

Ohio Oil Company

FIRST REPORT

Contractor

SE NE NW

SECTION PLAT

990 Ft. from N. Line

\_\_\_\_\_ Ft. from S. Line

330 Ft. from E. Line

\_\_\_\_\_ Ft. from W. Line

	o	.	.

Rice County

Location \_\_\_\_\_

Rig up \_\_\_\_\_

Drilling and Remarks:

surface hole

RECORD

Cased \_\_\_\_\_ in., \_\_\_\_\_ ft.

Sand \_\_\_\_\_

Gas \_\_\_\_\_

Oil \_\_\_\_\_

Total Depth \_\_\_\_\_

PRODUCTION

1st 24 hrs. Nat. \_\_\_\_\_

1st 24 hrs. after shot \_\_\_\_\_

Gas \_\_\_\_\_ Cu. Ft.

Dry Hole \_\_\_\_\_

Abandoned \_\_\_\_\_

Date

NOV 23 1943 19

S. J. LEWIS Scout

Map No. 49 Sec. 5 Twp. 20 R. 9W

Well No. 12 Proffitt

Ohio Oil Company

**COMPLETE**

Contractor

SE NE NW

*E11719*

**SECTION PLAT**

990 Ft. from N. Line

\_\_\_\_\_ Ft. from S. Line

330 Ft. from E. Line

\_\_\_\_\_ Ft. from W. Line

	σ		

Rice County

Location \_\_\_\_\_

Rig up \_\_\_\_\_

Drilling and Remarks:

*Per 78220*

*2" @ 3221*

*Run 500 ft*

*42 1/2*

**RECORD**

Cased \_\_\_\_\_ in., \_\_\_\_\_ ft.

Sand \_\_\_\_\_

Gas \_\_\_\_\_

Oil

Total Depth 3222

**PRODUCTION**

1st 24 hrs. Nat. \_\_\_\_\_

1st 24 hrs. after shot \_\_\_\_\_

Gas \_\_\_\_\_ Cu. Ft.

Dry Hole \_\_\_\_\_

Abandoned \_\_\_\_\_

Date

DEC 15 1948

19

S. J. LEWIS

Scout