


Map No. KANSAS Sec. 5 Twp. 20 R. 12

Well No. 1-Tinsley Farm  
Horak & Co Company

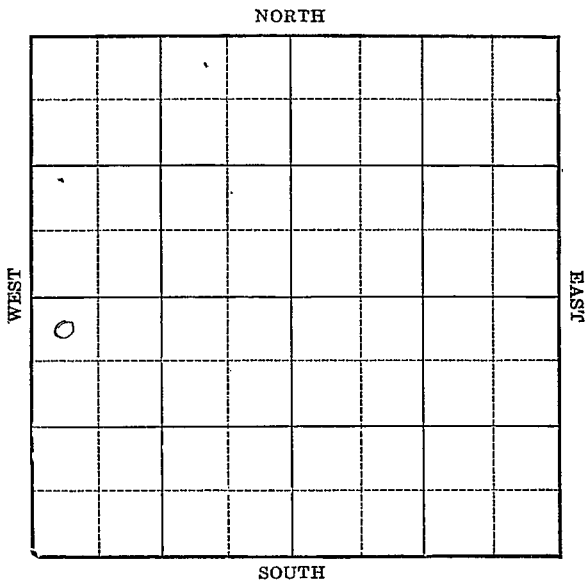

Location \_\_\_\_\_  
Drilling Remarks \_\_\_\_\_

Rig Up \_\_\_\_\_  
Drilling Remarks \_\_\_\_\_

\_\_\_\_\_  
\_\_\_\_\_  
**RECORD**

Cased \_\_\_\_\_ in. \_\_\_\_\_ ft.  
Sand \_\_\_\_\_  
Gas \_\_\_\_\_  
Oil \_\_\_\_\_  
Total Depth \_\_\_\_\_

**PRODUCTION**

1st 24 hrs. Nat. \_\_\_\_\_  
1st 24 hrs. after shot \_\_\_\_\_  
Gas \_\_\_\_\_ cu. ft.  
Dry Hole \_\_\_\_\_  
Abandoned \_\_\_\_\_

*McPherson*  
RM 252A-5M-8-30-PETROL

Map No. KANSAS Sec. 5 Twp. 20 R. 1<sup>W</sup>

Well No. 1 - Insley Farm  
Foraker Co Company

NORTH


330 Ft. from N. Line

\_\_\_\_\_ Ft. from S. Line

\_\_\_\_\_ Ft. from E. Line

330 Ft. from W. Line

1931

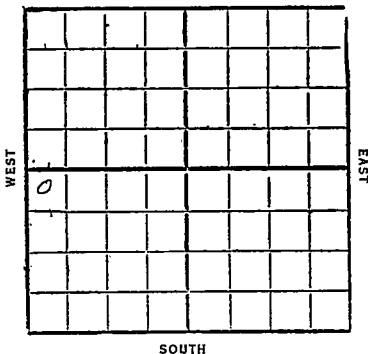

Date


REPORT

|      |                     |
|------|---------------------|
| 3/18 | Reel                |
| 3/25 | Reel                |
| 4/1  |                     |
| 4/18 |                     |
| 4/15 | Spud 8510           |
| 4/22 | Spdg.               |
| 4/29 | " 250'              |
| 5/6  | 15" - 415'          |
|      | Drilg 810'          |
| 5/13 | " 1368'             |
| 5/20 | " 1620'             |
| 5/27 |                     |
| 6/3  | Trsg 1857           |
| 6/10 | 510 1857            |
| 6/17 | Drilg by tools 1857 |
| 6/24 |                     |
| 7/1  | Clg out 1857        |
| 7/8  | Drilg. 1995'        |
| 7/15 | 10" - 2187          |
| 7/22 | TL 2305' U11R 10"   |
| 7/29 | 10" - 2395'         |
|      | drilg 2450'         |

8/5- drelg 2517  
8/12- " 2750  
8/19- SD 2750  
8/26- 8" 2750  
drelg 2805  
9/2- Top Chat 2951 cm  
drelg  
9/9- 2 H gas 2955-90  
HFW 3020-60  
SD 3060  
9/16- Drelg 3150  
9/23- SD 3162  
9/30- 5" 3162  
drelg 3399  
10/7- TD 3401 Fishing  
10/14 —  
10/21- Top Viola <sup>3440</sup>~~3451~~  
show oil  
10/28- Top Viola 3440' (SLM)  
show oil & water 3443  
3000' fluid, most water,  
at 3448  
drelg 3468  
1600' water & show oil  
11/4- Top Wilcox 3485  
SD 3500  
11/10- T.D. 3500  
Plug back to Viola  
11/18 —

Map No. Kans. Sec. 5 Twp. 20 R. 1W  
 Well No. 1-Tinsley Farm  
Toraker et al Company

NORTH

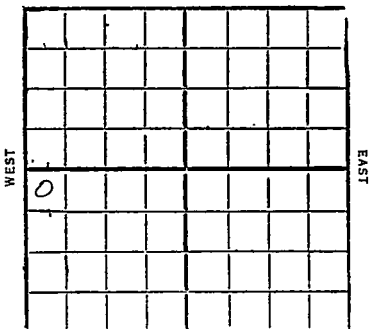

SOUTH

330 Ft. from N. Line

\_\_\_\_\_ Ft. from S. Line

\_\_\_\_\_ Ft. from E. Line

330 Ft. from W. Line

1931

Date

REPORT

|       |                        |
|-------|------------------------|
| 12/2  | TD 3510                |
|       | P.B. to 3474           |
|       | shot 30 qt, 3448-72    |
|       | No test                |
| 12/9  | P.B. to 3474 SD        |
| 12/16 | Cly out at 3474        |
| 12/22 | Shut down              |
| 12/30 | —                      |
| 1932  | —                      |
| 1/7   | —                      |
| 1/13  | —                      |
| 1/20  | —                      |
| 1/27  | —                      |
| 2/3   | (P.B. to 3474) Cly out |
| 2/10  | —                      |
| 2/17  | Shut down              |
| 2/26  | — 4/6 — 5/18 —         |
| 3/2   | — 4/13 — 5/25 —        |
| 3/9   | — 4/20 — 6/11 —        |
| 3/16  | — 4/27 — 6/18 —        |
| 3/22  | — 5/4 — 6/15 —         |
| 3/30  | — 5/11 — 6/22 —        |

6/29- T.D. 3510' water  
P.B. to 3474' SD

7/6 —

7/13 —

7/20 —

7/27 —

8/3 —

8/10 —

8/17 —

8/24- Top Viola 3451

" Welcox 3485

TD 3510

P.B. to 3474

shot 30 qt 3448-72

Dry & Abandon

*McPherson*  
 Map No. **KANSAS** Sec. 5 Twp. 20 R. 14

43  
 Well No. 1 Tinsley

Foraker & Co. Company

Contractor

## SECTION PLAT

380 Ft. from N. Line

..... Ft. from S. Line

..... Ft. from E. Line

330 Ft. from W. Line

|   |  |  |  |
|---|--|--|--|
|   |  |  |  |
|   |  |  |  |
| 0 |  |  |  |
|   |  |  |  |

## FIRST REPORTS

Location.....

Rig up.....

Drilling and Remarks:

*ROG*

## RECORD

Cased..... in., ..... ft.

Sand.....

Gas.....

Oil.....

Total Depth.....

## PRODUCTION

1st 24 hrs. Nat.....

1st 24 hrs. after shot.....

Gas..... Cu. Ft.

Dry Hole.....

Abandoned.....

Date

MAR 1 8 1931

192

S. J. LEWIS Scout

43 KANSAS

Map No. \_\_\_\_\_ Sec. 5 Twp. 20 R. 1

Well No. 1 Insley

Teraper Co. Company

Contractor

COMPLETED

SECTION PLAT

330 Ft. from N. Line

\_\_\_\_\_ Ft. from S. Line

\_\_\_\_\_ Ft. from E. Line

330 Ft. from W. Line

ABANDONED

|   |  |  |  |
|---|--|--|--|
|   |  |  |  |
|   |  |  |  |
| 0 |  |  |  |
|   |  |  |  |

Location \_\_\_\_\_

Rig up \_\_\_\_\_

Drilling and Remarks:

Top View 3451

" Niles 3485

PB To 3474

30/3448-72

## RECORD

Cased \_\_\_\_\_ in., \_\_\_\_\_ ft.

Sand \_\_\_\_\_

Gas \_\_\_\_\_

Oil \_\_\_\_\_

Total Depth: 3510

## PRODUCTION

1st 24 hrs. Nat. \_\_\_\_\_

1st 24 hrs. after shot \_\_\_\_\_

Gas \_\_\_\_\_ Cu. Ft.

Dry Hole ☒Abandoned ☒

Date

AUG 24 1932

CHAS. L. SHERWOOD

192

Scout