

KANSAS ✓

Sec. 24 Twp. Rice R. 6W

Well No. #1 Lindholm Farm _____

Staag Drlg. Company _____

Pabco Drlg. Contractor _____


990 Ft. from N. Line

_____ Ft. from S. Line

330 Ft. from E. Line

_____ Ft. from W. Line

SE NE SE

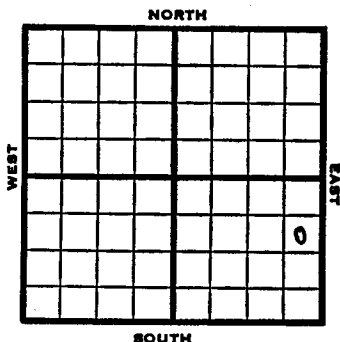

1953 Elev. 1525' REPORT

2/4 Spud 1-28-53
8" @ 130
Drlg. 310'

2/12 Miss Chat 3273,
RTD 3294
5" @ 3293 DD

2/19 DD 3317, TD 1500A
S/2½ BOPH 12 hrs., POP

2/25 Spud 1-28-53
TD 3317
8" @ 130
Miss 3273
TD 3294
5" @ 3293
DD 3317 1500A
S/2½ boph
Comp. 35 bopd


COMPLETED

Rice

Section 24 Township 20 KANSAS Range 6W

Well No. 1 Lindholm

Company Staag Drlg.

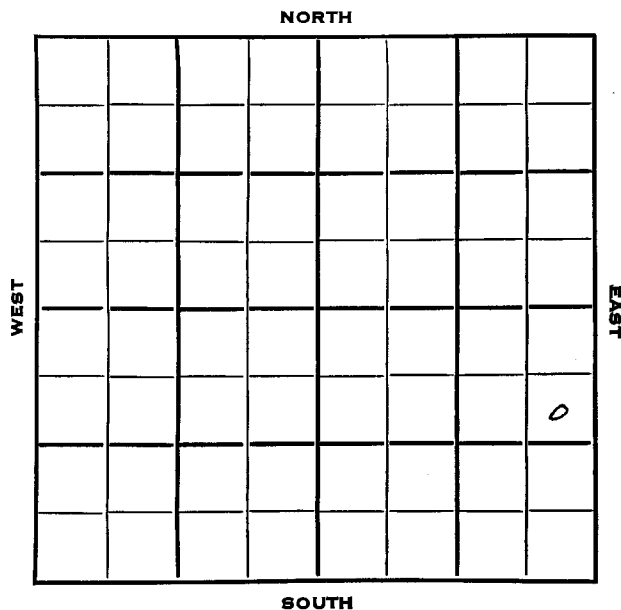

County Rice State Kansas
 Sec. 34 (Blk.) 20 (Sur.) 6W Map No.
 Operator Stang Drlg.
 Well No. 1 Farm Lindholm
 Elev. _____ Location SE NE SE
 000 Ft. From N Line SE
 330 Ft. From E Line Quarter
 1st. Report FEB 4 1953
 Completion _____
 Remarks _____
Pabco Drlg. - Contr.
 Spudding Date 1-28-53

Drlg. Data

8" @ 130 drig. 310

J. G. McGEHEE


County Rice State Kansas

Sec. 24 (Blk.
Twp.) 20 (Sur.
Rge.) 6W Map No. _____

Operator Staag Drlg.

Well No. 1 Farm Lindholm

Elev. 1525 Location SE NE SE

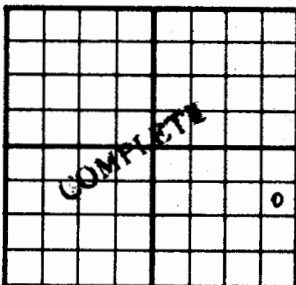

990 Ft. From N Line SE

330 Ft. From E Line Quarter

1st. Report

Completion FEB 25 1953

Remarks

Pabco Drlg. - Contr.

Spudding Date 1-28-53

Drlg. Data Oil well TD 3317

8" @ 130 Miss. 3273 TD 3294

5" @ 3293 DD 3317 1500 A S/ 2 $\frac{1}{2}$ boph

Comp. 35 bopd

McGEHEE