

KANSAS

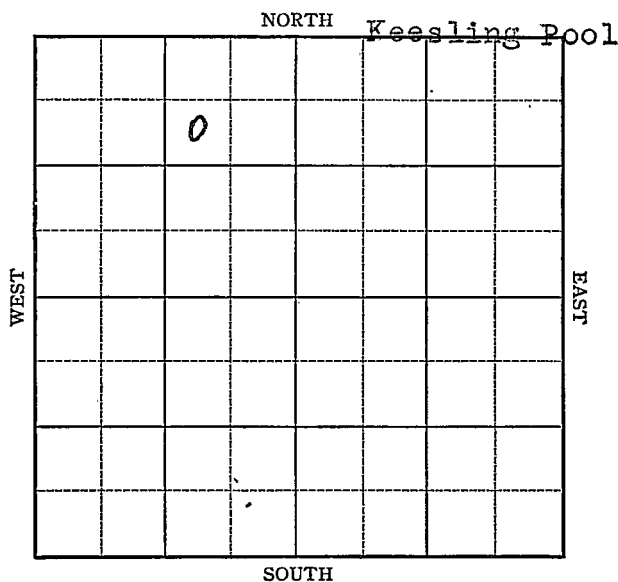
FORM 51 5M 4-41 PETROL

Rice

Section 6 Township 20 Range 9-W

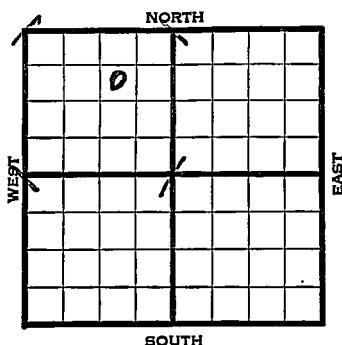
Well No. #1 Christopher 182A

Company Holl & Draine



Sec. 6 Twp. 20 R. 9-WWell No. #1 Christopher 182 acres ' FarmHoll & Braine Company

(Keesling)

990 Ft. from N. Line Ft. from S. Line Ft. from E. Line1650 Ft. from W. LineLong quarter - 182 acres.

1942 Elev. 1731 REPORT

5/27 Rotary.

6/3 "

6/10 10" - 218' Drlg. 1690'

6/17 Drlg. 1850'

6/24 Arb. 3303'

T.D. 3306 $\frac{1}{2}$ '

No shows.

ABANDONED

Map No. 49 Sec. 6 Twp. 20 R. 9WWell No. 1 Christopher 182A.Holl & Braine

Company

FIRST REPORT

Contractor

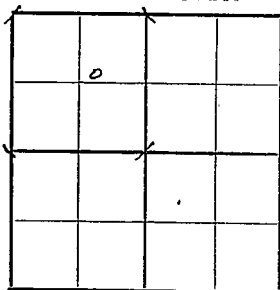
SECTION PLAT

SW NE NW

990 Ft. from N. Line

Ft. from S. Line

Ft. from E. Line

1650 Ft. from W. Line

KEESLING POOL

Location _____

Rig up _____

Drilling and Remarks:

Rotary

Long quarter
182, A.

RECORD

Cased _____ in., _____ ft.

Sand _____

Gas _____

Oil _____

Total Depth _____

PRODUCTION

1st 24 hrs. Nat. _____

1st 24 hrs. after shot _____

Gas _____ Cu. Ft.

Dry Hole _____

Abandoned _____

Date

MAY 27 1942₁₉

S. J. LEWIS Scout

Map No. 49 Sec. 6 Twp. 20 R. 9WWell No. 1 Christopher 182 A.Holl & Braine Company**ABANDONED**

Contractor

SW NE NW

SECTION PLAT

	0		

990 Ft. from N. Line Ft. from S. Line Ft. from E. Line1650 Ft. from W. Line

KEESLING POOL

Location Rig up

Drilling and Remarks:

*See 8303**No show*

RECORD

Cased in., ft.Sand Gas Oil Total Depth 8306 1/2

PRODUCTION

1st 24 hrs. Nat. 1st 24 hrs. after shot Gas Cu. Ft.Dry Hole Abandoned

Date

JUN 24 1942 19 S. J. LEWIS Scout