


Rice

Form 51-5M-11-31-Palace

Map No. **KANSAS** Sec. 6 Twp. 20 R. 9 W

Well No. 1 Proffitt Farm \_\_\_\_\_  
Empire Company \_\_\_\_\_

NORTH

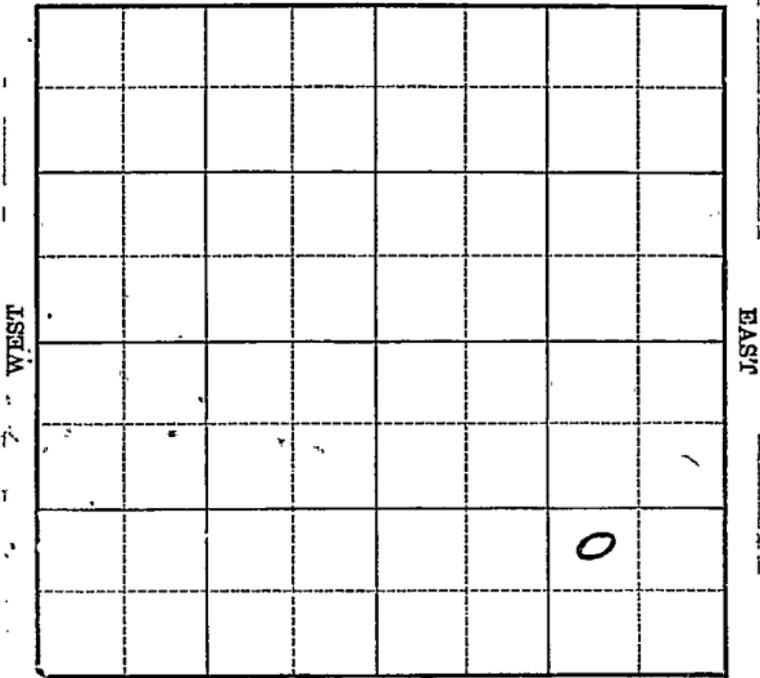

SOUTH

Location \_\_\_\_\_  
Drilling Remarks \_\_\_\_\_

Rig Up \_\_\_\_\_  
Drilling Remarks \_\_\_\_\_

\_\_\_\_\_  
\_\_\_\_\_  
**RECORD**

**PRODUCTION**

Cased \_\_\_\_\_ in. \_\_\_\_\_ ft.  
Sand \_\_\_\_\_  
Gas \_\_\_\_\_  
Oil \_\_\_\_\_  
Total Depth \_\_\_\_\_

1st 24 hrs. Nat. \_\_\_\_\_  
1st 24 hrs. after shot \_\_\_\_\_  
Gas \_\_\_\_\_ cu. ft. \_\_\_\_\_  
Dry Hole \_\_\_\_\_  
Abandoned \_\_\_\_\_

Rice

Map No. **KANSAS** Sec. 6 Twp 20 R. 9W


Well No. 1 Proffitt Farm \_\_\_\_\_  
Empire Company \_\_\_\_\_

\_\_\_\_\_ Ft. from N. Line

990 Ft. from S. Line

990 Ft. from E. Line

\_\_\_\_\_ Ft. from W. Line

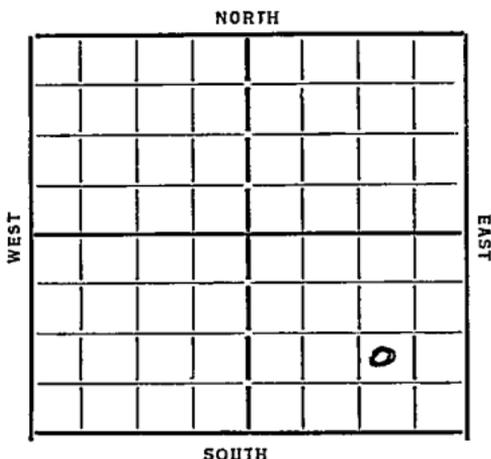

Date

REPORT

1934  
5/2 Dlg water wells  
5/10 Moving in  
5/18 —  
5/25 155 Spud  
5/31 Dlg 1055  
6/7 " 1750 12" 1595  
6/14 Log 2030  
6/21 10" 2045 S. N. 2110-20  
Dly 2235  
6/28 " 2735  
7/5 8" 2774 S.O. 3030 Dly 3240  
7/12 7. Sil 3265 TD 3268  
6" 3266 2900' oil 13 hrs.  
7/19 Run tubing  
7/25 Silicious 3265 TD 3268  
869 Bbls.

COMPLETED

KANSAS

Map No. 49 Sec. 6 Twp. 20 R. 9W

Well No. 1 - J. Proffitt

Empire Company

Contractor

FIRST REPORTS

SECTION PLAT

\_\_\_\_\_ Ft. from N. Line

990 Ft. from S. Line

990 Ft. from E. Line

\_\_\_\_\_ Ft. from W. Line

			0

Location \_\_\_\_\_

Rig up \_\_\_\_\_

Drilling and Remarks:

*100 yd water  
wells*

RECORD

Cased \_\_\_\_\_ in., \_\_\_\_\_ ft.

Sand \_\_\_\_\_

Gas \_\_\_\_\_

Oil \_\_\_\_\_

Total Depth \_\_\_\_\_

PRODUCTION

1st 24 hrs. Nat. \_\_\_\_\_

1st 24 hrs. after shot \_\_\_\_\_

Gas \_\_\_\_\_ Cu. Ft.

Dry Hole \_\_\_\_\_

Abandoned \_\_\_\_\_

Date

5-23 19

ORVAL MANN SCHRECK  
Scout

