


Map No. Rice **KANSAS** Sec. 6 Twp. 20 R. 9<sup>W</sup>

Well No. Roy Ramsey Farm Hilton Company

NORTH

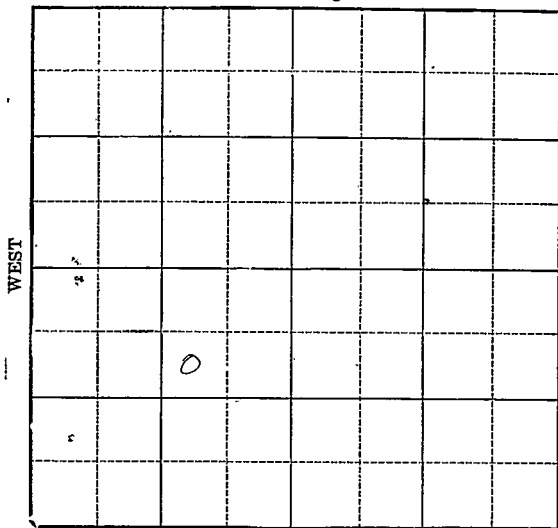

Location \_\_\_\_\_  
Drilling Remarks \_\_\_\_\_

Rig Up \_\_\_\_\_  
Drilling Remarks \_\_\_\_\_

**RECORD**

Cased \_\_\_\_\_ in. \_\_\_\_\_ ft.  
Sand \_\_\_\_\_  
Gas \_\_\_\_\_  
Oil \_\_\_\_\_  
Total Depth \_\_\_\_\_

**PRODUCTION**

1st 24 hrs. Nat. \_\_\_\_\_  
1st 24 hrs. after shot \_\_\_\_\_  
Gas \_\_\_\_\_ cu. ft.  
Dry Hole \_\_\_\_\_  
Abandoned \_\_\_\_\_

Rice

FORM 252A-5M-8-30-PETROL

Map No. KANSAS Sec. 6 Twp. 20 R. 9<sup>w</sup>

Well No. 1-Hilton Farm

Roy Ramsey Company


940 Ft. from N. Line

\_\_\_\_\_ Ft. from S. Line

940 Ft. from E. Line

\_\_\_\_\_ Ft. from W. Line

1932

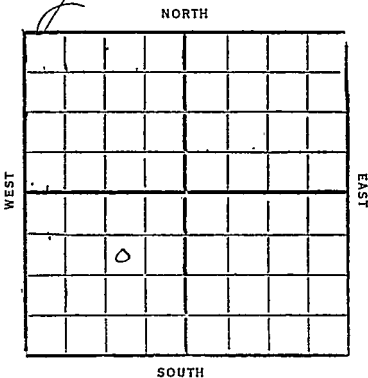

Date

REPORT

5/18 Log

5/25 Log

6/11 Run up

6/18 Spdy

6/15 15"-430

12"-1030

Drilg 1300'

6/22 10"-1705

Drilg 2025

6/29 HFW 2245-60

8"-2260

Drilg 2333

7/6 " 2550'

7/13 8"-2539

Top Lansing 2955

show oil 3045-60

6"-3185

TD 3235 UIR 6"

(over)

7/20 - Conglomerate 3270-88  
show oil 3287  
Silic lime 3297  
HFN 3319-23  
TD 3323  
Abandoned

Rice

49 KANSAS Sec. 6 Twp. 20 R. 9 W

Well No. 1 Hilton

Ray Ramsey Company

Contractor

FIRST REPORTS

990 Ft. from N. Line

Ft. from S. Line

990 Ft. from E. Line

Ft. from W. Line

SECTION PLAT

	0		

Location ✓

Rig up

Drilling and Remarks:

RECORD

Cased in., ft.

Sand

Gas

Oil

Total Depth

PRODUCTION

1st 24 hrs. Nat.

1st 24 hrs. after shot

Gas Cu. Ft.

Dry Hole

Abandoned

Date

MAY 1 8 1932 CHAS. L. SHERWOOD Scout

Rice

W

49 KANSAS

Map No. \_\_\_\_\_ Sec. 6 Twp. 20 R. 9

Well No. 1 Hiltow \_\_\_\_\_

Ray Ramsey

Company

Contractor

COMPLETED

SECTION PLAT

990 Ft. from N. Line

\_\_\_\_\_ Ft. from S. Line

990 Ft. from E. Line

\_\_\_\_\_ Ft. from W. Line

	0		

ABANDONED

Location \_\_\_\_\_

Rig up \_\_\_\_\_

Drilling and Remarks:

Long 3270-88  
 Shaw 3287  
 Siliceous 3297-  
 HFW 3319-73

RECORD

Cased \_\_\_\_\_ in., \_\_\_\_\_ ft.

Sand \_\_\_\_\_

Gas \_\_\_\_\_

Oil \_\_\_\_\_

Total Depth 3373

PRODUCTION

1st 24 hrs. Nat. \_\_\_\_\_

1st 24 hrs. after shot \_\_\_\_\_

Gas \_\_\_\_\_ Cu. Ft.

Dry Hole

Abandoned

Date

JUL 20 1932

CHAS. L. SHERWOOD

192

Scout