




Rice

Map No. KANSAS Sec. 6 Twp. 20 R. 9W

Well No. 7 Hilton Farm  
Ranney Company

990 Ft. from N. Line  
         Ft. from S. Line  
330 Ft. from E. Line  
         Ft. from W. Line

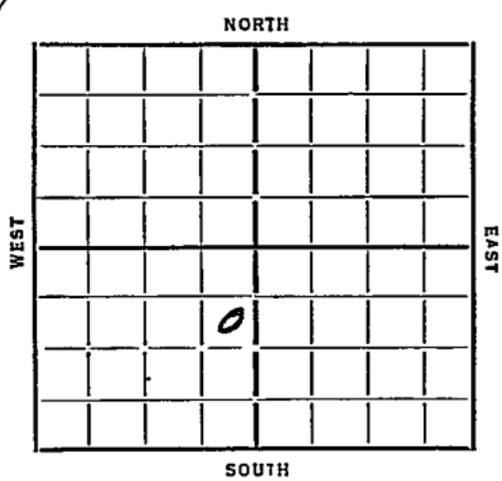

Date 1934 REPORT

12/26 Stk. Rig  
1/3/35 Rgn. up  
1/10 Spud  
1/7 42" 880 10" 1945  
         HFV 2245-60 8" 2272 Dlg 2360  
1/24 Trussing 2965 6" 3138  
         Dlg 3180  
1/31 Siliceous 3292 3301 600'  
         oil 6 hrs TD 3305 No Suc.  
         8 Bbls per hr 2000 acid  
2/7           
2/13 Siliceous 3292 TD 3305  
         2000 acid 233 Bbls.

COMPLETED

Map No. 49 Sec. 6 Twp. 20 R. 9W

Well No. 2. Hilton

Ramsey Company

Contractor

FIRST REPORTS

SECTION PLAT

990 Ft. from N. Line

..... Ft. from S. Line

330 Ft. from E. Line

..... Ft. from W. Line


Location.....

Rig up.....

Drilling and Remarks:

*Std. Rig*

RECORD

Cased..... in. .... ft.

Sand.....

Gas.....

Oil.....

Total Depth.....

PRODUCTION

1st 24 hrs. Nat.....

1st 24 hrs. after shot.....

Gas..... Cu. Ft.

Dry Hole.....

Abandoned.....

Date

12-26-31 192

ORVAL MANNSCHRECK

Scout

Map No. 49 Sec. 6 Twp. 20 R. 9W

Well No. 2-Hilton

Ramsey Company

Contractor

COMPLETED

SECTION PLAT

990 Ft. from N. Line

Ft. from S. Line

330 Ft. from E. Line

Ft. from W. Line


RECORD

Location.....

Rig up.....

Drilling and Remarks:

2000 acid

233 bbls

Cased..... in., ..... ft.

Sand silicurns 3292

Gas.....

Oil.....

Total Depth 3305

PRODUCTION

1st 24 hrs. Nat.....

1st 24 hrs. after shot.....

Gas..... Cu. Ft.

Dry Hole.....

Abandoned.....

Date

2-13-35 192

ORVAL MANNSCHRECK

Scout