


Map No. KANSAS Sec. 6 Twp. 20 R. 9W

Well No. 2 Proffit Farm  
Empire Oil Company

*Rice*

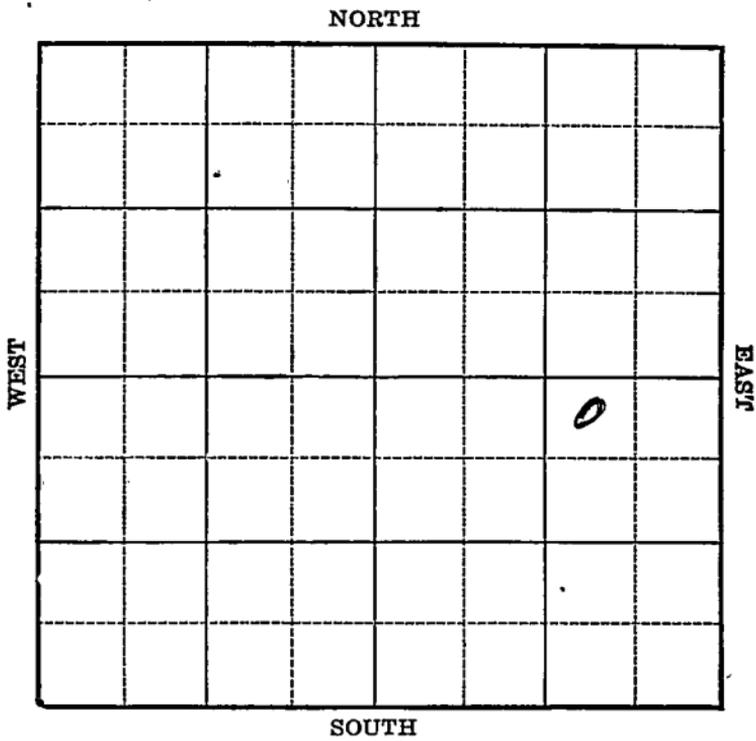

Location \_\_\_\_\_

Drilling Remarks \_\_\_\_\_

\_\_\_\_\_

\_\_\_\_\_

**RECORD**

Cased \_\_\_\_\_ in. \_\_\_\_\_ ft.

Sand \_\_\_\_\_

Gas \_\_\_\_\_

Oil \_\_\_\_\_

Total Depth \_\_\_\_\_

Rig Up \_\_\_\_\_

Drilling Remarks \_\_\_\_\_

\_\_\_\_\_

\_\_\_\_\_

**PRODUCTION**

1st 24 hrs. Nat. \_\_\_\_\_

1st 24 hrs. after shot \_\_\_\_\_

Gas \_\_\_\_\_ cu. ft. \_\_\_\_\_

Dry Hole \_\_\_\_\_

Abandoned \_\_\_\_\_



Map No. 49 Sec. 6 Twp. 20 R. 9W

Well No. 2 - proffit

Empire oil Company

Contractor

**FIRST REPORTS SECTION PLAT**

330 Ft. from N. Line

..... Ft. from S. Line

990 Ft. from E. Line

..... Ft. from W. Line

			o

Location.....

Rig up.....

Drilling and Remarks:

*cellar*

**RECORD**

Cased..... in., ..... ft.

Sand.....

Gas.....

Oil.....

Total Depth.....

**PRODUCTION**

1st 24 hrs. Nat.....

1st 24 hrs. after shot.....

Gas..... Cu. Ft.

Dry Hole.....

Abandoned.....

Date

**ORVAL MANSCHRECK**

1-16-35 192.....

Scout

Map No. 49 Sec. 6 Twp. 20 R. 9W

Well No. 2-Proffitt  
Empire oil Company

Contractor

COMPLETED

SECTION PLAT

330 Ft. from N. Line.

..... Ft. from S. Line

990 Ft. from E. Line

..... Ft. from W. Line

			0

Location.....

Rig up.....

Drilling and Remarks:

1000 sand

1609 lbs

RECORD

Cased..... in., ..... ft.

Sand silicious 3248

Gas.....

Oil.....

Total Depth 3258

PRODUCTION

1st 24 hrs. Nat.....

1st 24 hrs. after shot.....

Gas..... Cu. Ft.

Dry Hole.....

Abandoned.....

Date

ORVAL MANNSCHRECK

3-6-35 192.....

Scout