


Rice

Form 51—5M—11-31—Palace

Map No. KANSAS Sec. 6 Twp. 20 R. 9^w

Well No. 3 Christopher Farm
Gypsy Oil Company

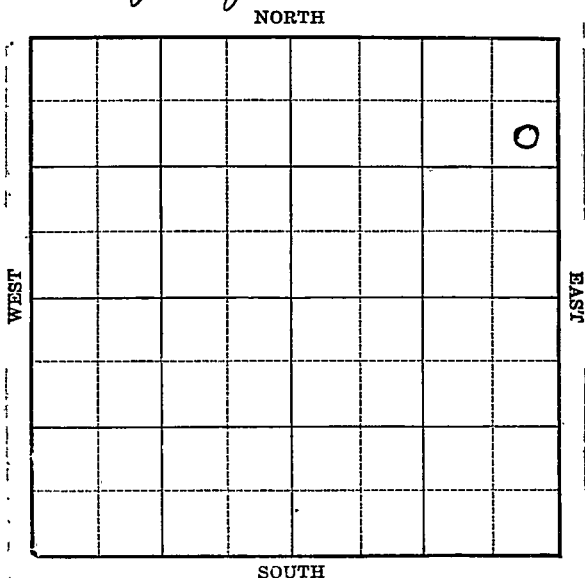

Location _____

Drilling Remarks _____

RECORD

Cased _____ in. _____ ft.

Sand _____

Gas _____

Oil _____

Total Depth _____

Rig Up _____

Drilling Remarks _____

PRODUCTION

1st 24 hrs. Nat. _____

1st 24 hrs. after shot _____

Gas _____ cu. ft.

Dry Hole _____

Abandoned _____

Rice

Map No. KANSAS Sec. 6 Twp. 20 R. 9W

Well No. 3 Christopher Farm


Gypsy Oil Company

990 Ft. from N. Line

 Ft. from S. Line

330 Ft. from E. Line

 Ft. from W. Line

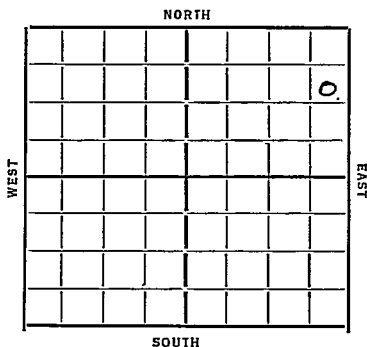

Date 1934

REPORT

2/7	Building Rig	
2/14	Spud	
2/23	Drily 895	15 1/2" 335
3/1	" 1910	12" 1560
3/8	Fixing 2620	
3/15	Drily 2175	10" at 2060
3/22	" 2305	
3/29	" 2560	
4/5	" 2920	
4/18	Silicene 3239 TD 3244	
	1555 Bbls.	

COMPLETED

Map No. 49 Sec. 6 Twp. 20 R. 9WWell No. 3-ChristopherHydroy oil Company

Contractor

FIRST REPORTS

SECTION PLAT

990 Ft. from N. Line

Ft. from S. Line

330 Ft. from E. Line

Ft. from W. Line

			0
	1		

Location

Rig up

Drilling and Remarks:

B.R.

RECORD

Cased.....in., ...ft.

Sand.....

Gas.....

Oil.....

Total Depth.....

PRODUCTION

1st 24 hrs. Nat.....

1st 24 hrs. after shot.....

Gas.....Cu. Ft.

Dry Hole.....

Abandoned.....

Date

2-7-34 192 O. Mannschreck Scout

KANSAS

Map No. 49 Sec. 6 Twp. 20 R. 9WWell No. 3-ChristopherHeavy oil Company

Contractor

COMPLETED

SECTION PLAT

			0

990 Ft. from N. Line

_____ Ft. from S. Line

330 Ft. from E. Line

_____ Ft. from W. Line

Location _____

Rig up _____

Drilling and Remarks: _____

RECORD

Cased _____ in., _____ ft.


Gas _____

Oil _____

Total Depth 3244

PRODUCTION

1st 24 hrs. Nat. _____

1st 24 hrs. after shot _____

Gas _____ Cu. Ft.

Dry Hole _____

Abandoned _____

1555
bbbs

Date

4-18-31

ORVAL MANNSCHRECK

Scout