

Rice

KANSASSection 6 Township 20 Range 9WWell No. #3 "A" ChristopherCompany Branine & Holl

Chase Pool

NORTH

0							

WEST

EAST

SOUTH

Rice

KANSAS

Sec. 6 Twp. 20 R. 9W

Well No. #3 "A" Christopher Farm

Branine & Holl

Company

Chase Pool (Herndon Drlg., Contr.)

Ft. from N. Line


280'

Ft. from S. Line

Ft. from E. Line

280' Ft. from W. Line

SW NW Twin Well

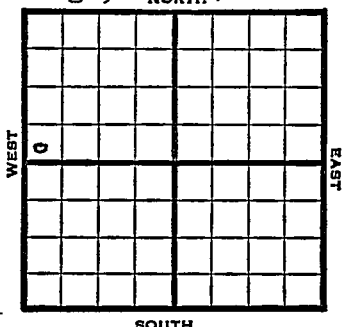

1949

Elev 1739' REPORT

12/7

8" @ 190'

Drlg. 1430'

12/14

Simpson 3281'

TD 3283'

5" @ 3281'

12/21

"

12/28

"

1950

1/18

TD 3292'

8" @ 190'

Lans 2946'

Simp 3287'

Arb. 3283'

D&A

Aband.

ABANDONED

Map No. _____ Sec. 6 Twp. 20 R. 9W

Well No. 3 "A" Christopher

Branine & Holl Company

Herndon Drlg. Contractor

SW NW

**FIRST REPORT
SECTION PLAT**

_____ Ft. from N. Line

280 Ft. from S. Line

_____ Ft. from E. Line

280 Ft. from W. Line

o			

Rice County

Location _____

Rig up _____

Drilling and Remarks:

twin well

8" @ 190

drlg. 1430

RECORD

Cased _____ in., _____ ft.

Sand _____

Gas _____

Oil _____

Total Depth _____

PRODUCTION

1st 24 hrs. Nat. _____

1st 24 hrs. after shot _____

Gas _____ Cu. Ft.

Dry Hole _____

Abandoned _____

Date

DEC 7 1949 19

S. J. LEWIS Scout

Map No. _____ Sec. 6 ^{Kansas} Twp. 20 R. 9W

Well No. 3-A Christopher

Branine & Holl

Company

Contractor

SW NW

6 lv. 1739
SECTION PLAT

ABANDONED			
o			

Ft. from N. Line

280

Ft. from S. Line

Ft. from E. Line

280

Ft. from W. Line

Rice County

Location _____

Rig up _____

Drilling and Remarks:

8" @ 190
Lans - 2946
Sings 3287
and 3283

D & A

RECORD

Cased _____ in., _____ ft.

Sand _____

Gas _____

Oil _____

Total Depth 3292

PRODUCTION

1st 24 hrs. Nat. _____

1st 24 hrs. after shot _____

Gas _____ Cu. Ft.

Dry Hole _____

Abandoned _____

Date

JAN 18 1950

19

J. E. TYRA

Scout