

Section 6 Township 20 Range 9WWell No. 3 ~~8~~ HiltonCompany R amsey PetChase Pool
NORTH

0							

WEST

EAST

SOUTH

KANSAS

Rice

Sec. 6 Twp. 20 R. 9W ☒

Well No. #13 ~~#8~~ **Hilton** Farm

Ramsey Pet. Company

Chase Pool


990' Ft. from N. Line

_____ Ft. from S. Line

_____ Ft. from E. Line

330' Ft. from W. Line

SW NW SW

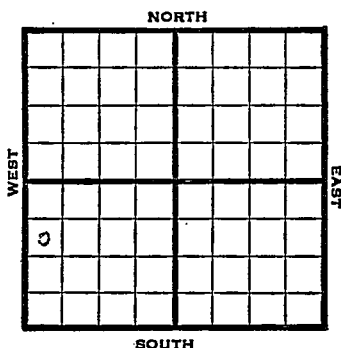

1948

Eli 1743'

REPORT

9/15

Location

9/21

8" @ 190'

Drig. 2158'

9/29

Lansing 2938'

Simpson 3270'

TD 3273'

5" @ 3267½'

10/6

"

10/13

"

10/19

"

10/27

TD 3276½'

Simp Sd 3270'

5" @ 3267½'

Arb. 3275'

Pump 10 oil Pot

42° Gr.

Comp

COMPLETED

Rice County Kansas State

Map No. _____ Sec. 6 Twp. 20 R. 9W

Well No. 8 Hilton

Ramsey Pet. Company

FIRST REPORT

Contractor

SW NW SW

SECTION PLAT

990 Ft. from N. Line

_____ Ft. from S. Line

_____ Ft. from E. Line

330 Ft. from W. Line

o							

Chase Pool

Remarks:

Location

Date

SEP 15 1948

Scout

S. J. LEWIS

Rice County Kansas State
Map No. 49 Sec. 6 Twp. 20 R. 9W


Well No. 3 Hilton

Ramsey Pet. Company

CORRECTION Contractor

SW NW SW

SECTION PLAT

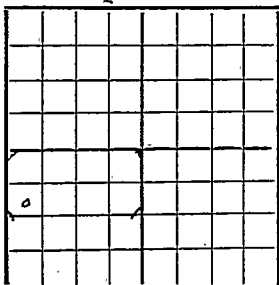

990 Ft. from N. Line

 Ft. from S. Line

 Ft. from E. Line

330 Ft. from W. Line

Chase Pool

Remarks:

Reported as #8 Hilton

Date
SEP 29 1948

Scout S. J. LEWIS

Map No. 49 Sec. 6 Twp. 20 R. 9W

Well No. 3 Hilton

Ramsey Pet. Company

COMPLETE

Contractor

SW NW SW

E 11743
SECTION PLAT

990 Ft. from N. Line

 Ft. from S. Line

 Ft. from E. Line

330 Ft. from W. Line

0			

Rice County

Location

Rig up

Drilling and Remarks:

Simple Sol 3270

5' @ 326 1/2

Cr 3275

Pump 10 oil P.D.

42 @ 3275

RECORD

Cased in., ft.

Sand

Gas

Oil

Total Depth 3276 1/2

PRODUCTION

1st 24 hrs. Nat.

1st 24 hrs. after shot

Gas Cu. Ft.

Dry Hole

Abandoned

Date

OCT 27 1948

19

S. J. LEWIS

Scout