

KANSAS


Form 51-5M-4-36-Palace

Rice

Section 6 Township 20 Range 9W

Well Number #3 ~~#~~ Hilton - "A"

Company Ramsey Pet

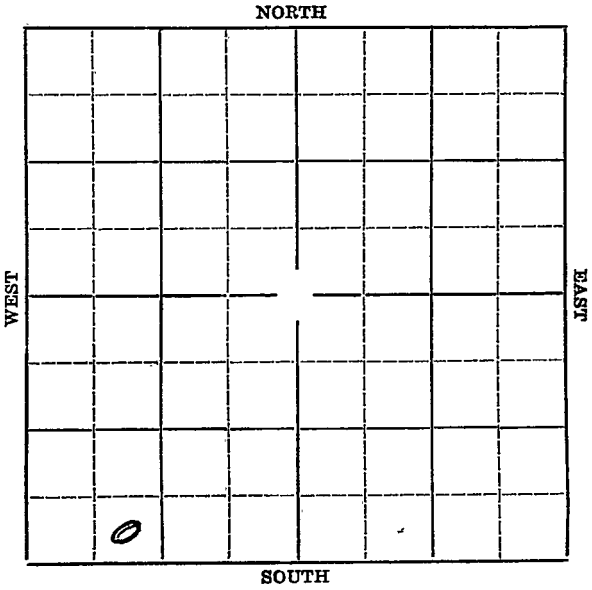

RICE.

Map No. **KANSAS** Sec. **6** Twp. **20** R. **9W**

Well No. ~~#4 Hilton~~ **3 Hilton "A"** Farm

Ramsey Pet. Company


_____ Ft. from N. Line

330' Ft. from S. Line

_____ Ft. from E. Line

990' Ft. from W. Line

Elev. 1741

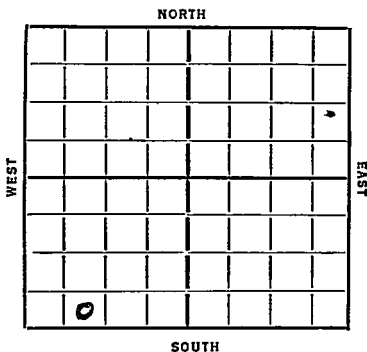

Date **1936**

REPORT

- 5/20** Building rig.
- 5/28** --
- 6/4** Rigging up.
- 6/11** Shut down.
- 6/18** 890'. Shut down.
- 6/25** --7/2--7/2--7/16--7/23--
- 7/30** Drlg. 1105'.
- 8/6** Drlg. 2050'. 10" @ 1940'.
- 8/13** 8½" @ 2210'. Drlg. 2825'.
- 8/20** Siliceous 3278'. TD 3278'. 2900'
of oil in 1½ hours.
- 8/27** 1341 bbls of oil. Show of water.
Natural. 1000 gallons acid.
No test.
- 9/3** --
- 9/9/36** Sil. 3278'.
T.D. 3284'.
1000 gallons acid.
Potential 1190 bbls of oil and
400 barrels of water.

COMPLETED

KANSASMap No. 49 Sec. 6 Twp. 20 R. 9WWell No. 4 HiltonRamsey P & S Company

Contractor

SECTION PLAT

 Ft. from N. Line330 Ft. from S. Line Ft. from E. Line990 Ft. from W. Line**FIRST REPORT**Location Rig up

Drilling and Remarks:

Building rig**RECORD**Cased in., ft.Sand Gas Oil Total Depth **PRODUCTION**1st 24 hrs. Nat. 1st 24 hrs. after shot Gas Cu. Ft.Dry Hole Abandoned

Date

MAY 20 1936 19

S. J. LEWIS

Scout

KANSAS

Map No. 49 Sec. 6 Twp. 20 R. 9W

Well No. 3 Hilton A

Ramsay P & S Company

Contractor

SECTION PLAT

_____ Ft. from N. Line

330 Ft. from S. Line

_____ Ft. from E. Line

990 Ft. from W. Line

CORRECTION

Location _____

Rig up _____

Drilling and Remarks:

*Reported
as No 4*

RECORD

Cased _____ in., _____ ft.

Sand _____

Gas _____

Oil _____

Total Depth _____

PRODUCTION

1st 24 hrs. Nat. _____

1st 24 hrs. after shot _____

Gas _____ Cu. Ft.

Dry Hole _____

Abandoned _____

Date 2 1936
SEP

S. J. LEWIS

KANSAS

Form 26 - 1M Bks. - 2-29

Map No. 49 Sec. 6 Twp. 20 R. 9W

Well No. 3 A Hilton

Ramsey P & S. Company

Contractor

SECTION PLAT

_____ Ft. from N. Line

230 Ft. from S. Line

_____ Ft. from E. Line

990 Ft. from W. Line

COMPLETED

Location _____

Rig up _____

Drilling and Remarks:

Sil 3278
1000 acid
P & S 1190 oil
400 water

RECORD

Cased _____ in., _____ ft.

Sand _____

Gas _____

Oil _____

Total Depth 3284

PRODUCTION

1st 24 hrs. Nat. _____

1st 24 hrs. after shot _____

Gas _____ Cu. Ft.

Dry Hole _____

Abandoned _____

Date

SEP 9 1936 19

S. I. LEWIS Scout