


Rice

Form 51-5M-11-31-Palace

Map No. **KANSAS** Sec. 6 Twp. 20 R. 9 W

Well No. 4 Christopher Farm
Gypsy Oil Company

NORTH

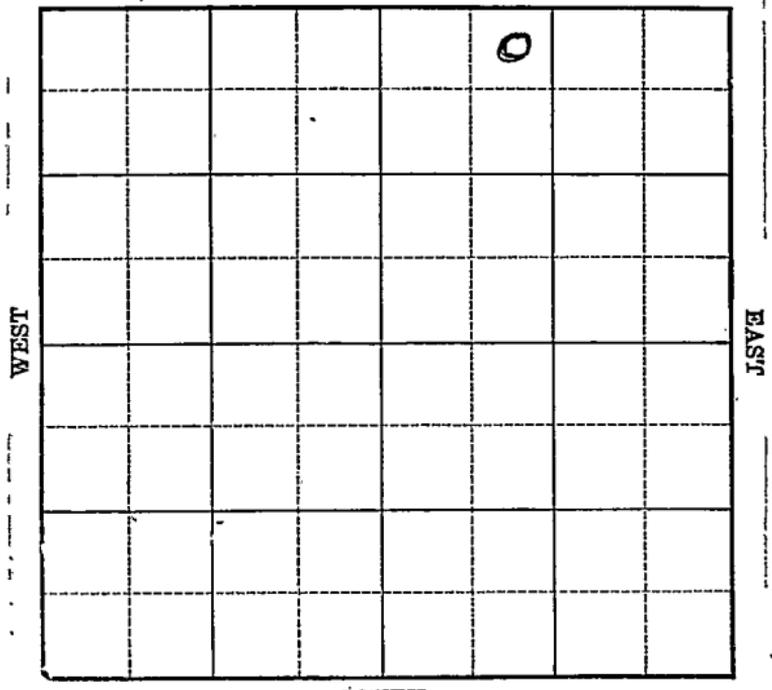

Location _____

Drilling Remarks _____

Rig Up _____

Drilling Remarks _____

RECORD

Cased _____ in. _____ ft.

Sand _____

Gas _____

Oil _____

Total Depth _____

PRODUCTION

1st 24 hrs. Nat. _____

1st 24 hrs. after shot _____

Gas _____ cu. ft.

Dry Hole _____

Abandoned _____

KANSAS

Map No. 49 Sec. 6 Twp. 20 R. 9N

Well No. 4 - Christopher

Pyppy Oil

Company

Contractor

FIRST REPORTS

SECTION PLAT

330 Ft. from N. Line

_____ Ft. from S. Line

_____ Ft. from E. Line

990 Ft. from W. Line

		0	

Location _____

Rig up _____

Drilling and Remarks:

Material

RECORD

Cased _____ in., _____ ft.

Sand _____

Gas _____

Oil _____

Total Depth _____

PRODUCTION

1st 24 hrs. Nat. _____

1st 24 hrs. after shot _____

Gas _____ Cu. Ft.

Dry Hole _____

Abandoned _____

Date

5-2-34 19

ORVAL MANNSCHRECK

Scout

Map No. 49 Sec. 6 Twp. 20 R. 9W

Well No. 4-Christopher

Gypsy Oil Company

Contractor

COMPLETED

SECTION PLAT

		0	

330 Ft. from N. Line.

_____ Ft. from S. Line

_____ Ft. from E. Line

990 Ft. from W. Line

Location _____

Rig up _____

Drilling and Remarks: _____

1605 lbs

RECORD

Cased _____ in., _____ ft.

Sand siliceous 3726

Gas _____

Oil _____

Total Depth 3233

PRODUCTION

1st 24 hrs. Nat. _____

1st 24 hrs. after shot _____

Gas _____ Cu. Ft.

Dry Hole _____

Abandoned _____

Date

6-15-34 19

ORVAL MANSCHRECK Scout