

KANSAS

Rice

Section 6 Township 20 Range 9WWell No. 4 ChristopherCompany Holl & Branine

Chase Pool

NORTH

	0						

WEST

EAST

SOUTH

KANSAS

Rice



Sec. 6 Twp. 20 R. 9W

Well No. #4 Christopher Farm

Holl & Branine Company

Chase Pool


NORTH

 Ft. from N. Line

330' Ft. from S. Line

 Ft. from E. Line

990' Ft. from W. Line

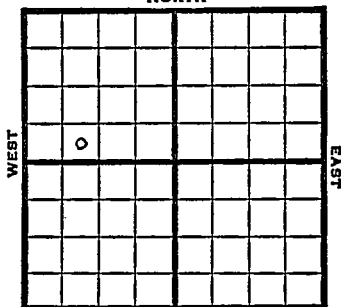

SE SW NW

173 1/2' (per test)

1948

Elev. ~~1738'~~ REPORT

12/8 RUR

12/14 8" @ 257'
Drlg. 2290'

12/22 Lansing 2945'
BKC 3216'
Simpson Sd 3261'
TD 3264'
5" @ 3261'

12/29 "

1949

1/5 Arb. 3269'
5" @ 3261'
Pump 85 oil Pot.
Gr. 42°
TD 3271
Gr. 42°

COMPLETED

Map No. _____ Sec. 6 Twp. 20 R. 9W

Well No. 4 Christopher

Holl & Branine Company

FIRST REPORT

 Contractor

SE SW NW

SECTION PLAT


_____ Ft. from N. Line

330

_____ Ft. from S. Line

_____ Ft. from E. Line

990 Ft. from W. Line

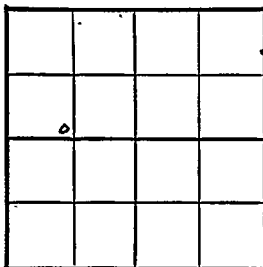

Rice County

Location _____

Rig up _____

Drilling and Remarks:

R U R

RECORD

Cased _____ in., _____ ft.

Sand _____

Gas _____

Oil _____

Total Depth _____

PRODUCTION

1st 24 hrs. Nat. _____

1st 24 hrs. after shot _____

Gas _____ Cu. Ft.

Dry Hole _____

Abandoned _____

Date

DEC 8 1948

19

S. J. LEWIS

Scout

Kansas

Chase Pool


Map No. 49 Sec. 6- Twp. 20 R. 9WWell No. 4 ChristopherHoll & Branine

Company

COMPLETE

Contractor

SE SW NW

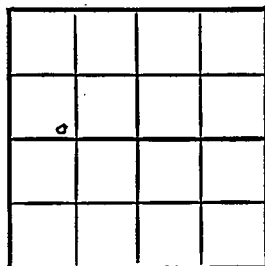E11786.
SECTION PLAT Ft. from N. Line330 Ft. from S. Line Ft. from E. Line990 Ft. from W. Line

Rice County

Location Rig up

Drilling and Remarks:

*Ce 73267**5" @ 3261**Run 80 Oil 2 1/2**42° S*

RECORD

Cased in., ft.Sand Gas Oil ✓Total Depth 3271

PRODUCTION

1st 24 hrs. Nat. 1st 24 hrs. after shot Gas Cu. Ft.Dry Hole Abandoned

Date

JAN 5 1949 19

S. J. LEWIS

Scout