

Map No.

KANSAS

Sec.

Twp.

R.

Well No.

Farm

Company

NORTH

WEST

EAST

SOUTH

Location

Drilling Remarks

Rig Up

Drilling Remarks

RECORD

Cased _____ in. _____ ft.

Sand _____

Gas _____

Oil _____

Total Depth _____

PRODUCTION

1st 24 hrs. Nat. _____

1st 24 hrs. after shot _____

Gas _____ cu. ft. _____

Dry Hole _____

Abandoned _____

Rice

Map No. KANSAS Sec. 6 Twp. 20 R. 9W


Well No. 4- Proffitt Farm
Empire Oil Company

330 Ft. from N. Line

_____ Ft. from S. Line

_____ Ft. from E. Line

990 Ft. from W. Line

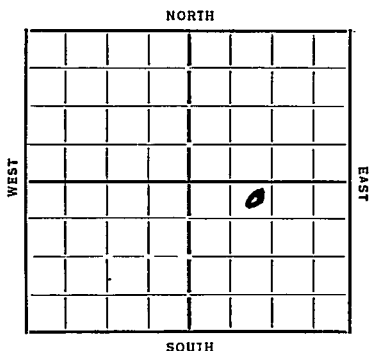

Date	REPORT
1935	
3/6	Material
3/14	Bldg.
3/21	15" 163 WOC
3/28	Bldg 1931
4/4	" 2994
4/11	Simpson 3246. 8" 3249 WOC.
4/18	Sil 3260 6" liner 3261
	800' oil 3271 Tubing.
4/26	248 Bbls oil P/H Rat
	490' w P/B to acidize
5/2	1000 acid
5/9	— 5/16 —
5/22	Silicious 3260 T 7.3267
	1000 acid 629 Bbls.

COMPLETED

KANSAS

Map No. 49 Sec. 6 Twp. 20 R. 9WWell No. 4-ProffittEmpire oil

Company

Contractor

FIRST REPORTS

330 Ft. from N. Line

Ft. from S. Line

Ft. from E. Line

990 Ft. from W. Line

SECTION PLAT

		0	
1			

Location

Rig up

Drilling and Remarks:

RECORD

Cased in., ft.

Sand

Gas

Oil

Total Depth

PRODUCTION

1st 24 hrs. Nat.

1st 24 hrs. after shot

Gas Cu. Ft.

Dry Hole

Abandoned

Date

ORVAL MANNSCHRECK

3-6-35 192

Scout

KANSAS

Map No. 49 Sec. 6 Twp. 20 R. 9WWell No. 4 ProffittEmpire oil

Company

Contractor

COMPLETED

SECTION PLAT

330 Ft. from N. Line

Ft. from S. Line

Ft. from E. Line

990 Ft. from W. Line

		0	

Location

Rig up

Drilling and Remarks:

1000 and629 bbls

RECORD

Cased _____ in., _____ ft.

Sand Silicious 3260

Gas _____

Oil _____

Total Depth 3267

PRODUCTION

1st 24 hrs. Nat. _____

1st 24 hrs. after shot _____

Gas _____ Cu. Ft.

Dry Hole _____

Abandoned _____

ORVAL MANNESMANN

Date

5-22-35

192

Scout