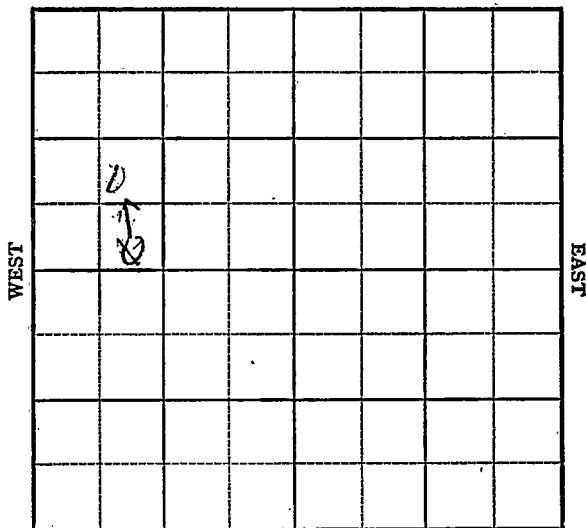


KANSAS

Rice

Section 6 Township 20 Range 9WWell No. 5 ChristopherCompany Holl & BraninChase
NORTH

SOUTH

Rice

Sec. 6 **KANSAS** Twp. 20 R. 9W ✓


Well No. #5 Christopher Farm
Holl & Branine Company

 Ft. from N. Line

990' Ft. from S. Line

 Ft. from E. Line

990' Ft. from W. Line

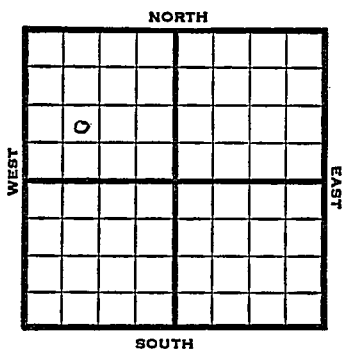

NE SW NW

1949

Elev 1736' REPORT

2/9 Location

2/16 8" @ 222'
Drlg. 1640'

2/23 "

3/2 Lansing 2943'
Simpson 3258'
Arbuckle 3260'
TD
5" @ 3260'

3/8 "

3/16 "

3/23 TD 3261'
Simp 3258'
Arb. 3260'
5"@ 3260'
Pump 120 Oil Pot
42° Gr.
Comp

COMPLETED

Kansas

Chase

Map No. _____ Sec. 6 Twp. 20 R. 9 WWell No. 5 ChristopherHoll & Brown Company

FIRST REPORT

Contractor

NE SW NW

SECTION PLAT

2			

_____ Ft. from N. Line

990 Ft. from S. Line

_____ Ft. from E. Line

990 Ft. from W. Line

Rice

Location ✓

Rig up _____

Drilling and Remarks:

RECORD

Cased _____ in., _____ ft.

Sand _____

Gas _____

Oil _____

Total Depth _____

PRODUCTION

1st 24 hrs. Nat. _____

1st 24 hrs. after shot _____

Gas _____ Cu. Ft.

Dry Hole _____

Abandoned _____

Date

FEB 9 1949 19

S. J. LEWIS

Scout

Map No. 49 Sec. 6 Twp. 20 R. 9W

Well No. 5 Christopher

Holl & Branine Company

COMPLETE

Contractor

NE SW NW

E 11786
SECTION PLAT

 Ft. from N. Line

990 Ft. from S. Line

 Ft. from E. Line

990 Ft. from W. Line

o			

Rice County

RECORD

Location

Rig up

Drilling and Remarks:

Cased in., ft.

Sand

Gas

Oil

Total Depth 3261

PRODUCTION

1st 24 hrs. Nat.

1st 24 hrs. after shot

Gas Cu. Ft.

Dry Hole

Abandoned

Date

MAR 23 1949 19 S. J. LEWIS Scout