


Section 6 Township 20 Range 9W

Well No. 6 Hilton

Company Ramsey Pet.

Chase Pool

NORTH

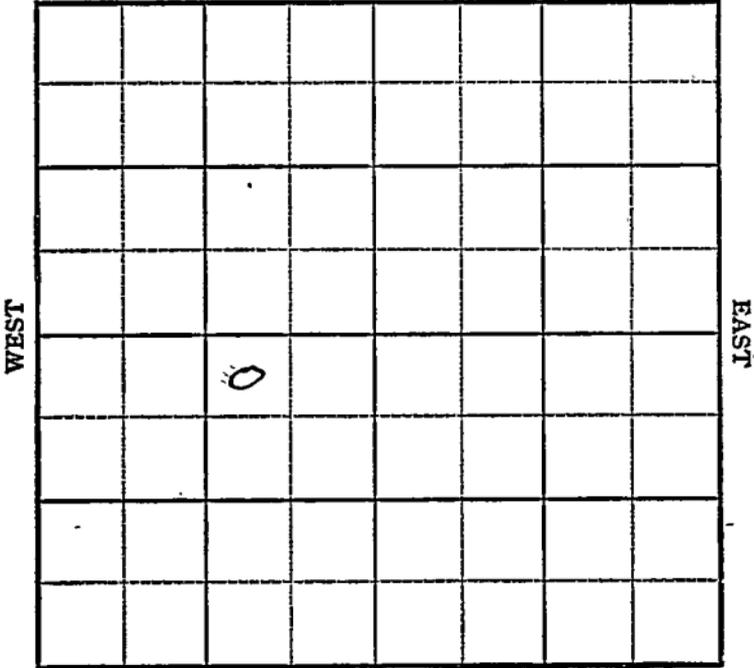

SOUTH

Sec. 6 Twp. 20 R. 9-W ✓

Well No. #6 Hilton Farm

Ramsey Pet. Company

Chase Pool


330 Ft. from N. Line

_____ Ft. from S. Line

990 Ft. from E. Line

_____ Ft. from W. Line

NW NE SW

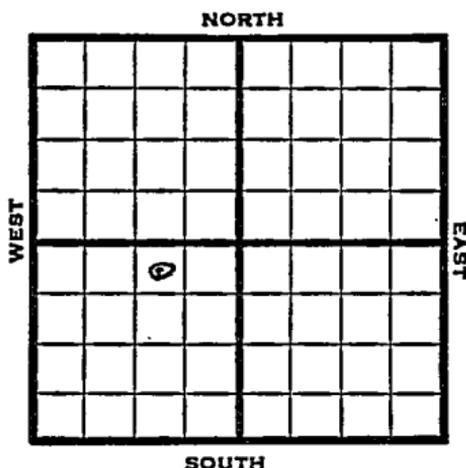

1948 **Eli 1731'** REPORT

11/3	8" @ 190'
11/10	Drlg 1950' Lansing 2944' Arb. 3278-81' TD 3281' 5" @ 3279'
11/16	"
11/23	Drlg 3301'
12/1	TD 3281' Arb. 3278' Aband.

ABANDONED

Map No. _____ Sec. 6 Twp. 20 R. 9W

Well No. 6 Hilton

Ramsey Pet. Company

FIRST REPORT Contractor

NW NE SW

SECTION PLAT

330 Ft. from N. Line

_____ Ft. from S. Line

990 Ft. from E. Line

_____ Ft. from W. Line

	o		

Rice County

RECORD

Location _____

Cased _____ in., _____ ft.

Rig up _____

Sand _____

Drilling and Remarks:

Gas _____

8" @ 190

Oil _____

drlg. 1950

Total Depth _____

PRODUCTION

1st 24 hrs. Nat. _____

1st 24 hrs. after shot _____

Gas _____ Cu. Ft.

Dry Hole _____

Abandoned _____

Date

NOV 3 1948 19

S. J. LEWIS Scout

Map No. 49 Sec. 6 Twp. 20 R. 9W

Well No. 6 Hilton

Ramsey Pet. Company

ABANDONED

Contractor

NW NE SW

E. 1, 1731
SECTION FLAT

330 Ft. from N. Line

_____ Ft. from S. Line

990 Ft. from E. Line

_____ Ft. from W. Line

Rice County

Location _____

Rig up _____

Drilling and Remarks:

Cur 3278

RECORD

Cased _____ in., _____ ft.

Sand _____

Gas _____

Oil _____

Total Depth 3277

PRODUCTION

1st 24 hrs. Nat. _____

1st 24 hrs. after shot _____

Gas _____ Cu. Ft.

Dry Hole _____

Abandoned _____

Date

DEC 1 1948 19

S. J. LEWIS Scout