


Map No. KANSAS Sec. 6 Twp. 20 R. 9WWell No. 6-Proffit FarmEmpire Oil Company

NORTH

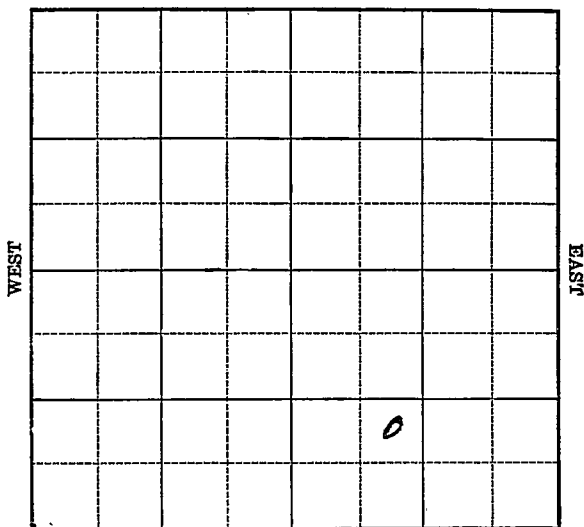

SOUTH

Location _____

Drilling Remarks _____

RECORD

Cased _____ in. _____ ft.

Sand _____

Gas _____

Oil _____

Total Depth _____

Rig Up _____

Drilling Remarks _____

PRODUCTION

1st 24 hrs. Nat. _____

1st 24 hrs. after shot _____

Gas _____ cu. ft.

Dry Hole _____

Abandoned _____

Rice

Map No. KANSA. Sec. 6 Twp. 20 R. 9W


Well No. 6-Proffit Farm
Empire Oil Company

 Ft. from N. Line

990 Ft. from S. Line

 Ft. from E. Line

990 Ft. from W. Line

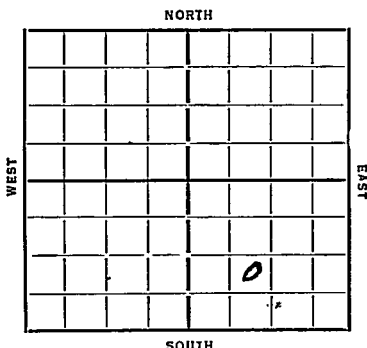

Date 1935

REPORT

3/13 Location

3/21 Ponds

3/28 Rig

4/4

4/11 Rig Rot.

4/18 Alg 1935

4/24 3060

5/2 Sil 3254 1600' oil 3259

5/8 Siliceous 3254

T 7 3259

752 Bbls 22 hrs.

COMPLETED

KANSAS

Map No. 47 Sec. 6 Twp. 20 R. 9WWell No. 6 - proffitEmpire Oil

Company

Contractor

FIRST REPORTS

Ft. from N. Line

990 Ft. from S. Line

Ft. from E. Line

990 Ft. from W. Line

SECTION PLAT

		0	

Location ☒

Rig up

Drilling and Remarks:

RECORD

Cased _____ in., _____ ft.

Sand _____

Gas _____

Oil _____

Total Depth _____

PRODUCTION

1st 24 hrs. Nat. _____

1st 24 hrs. after shot _____

Gas _____ Cu. Ft.

Dry Hole _____

Abandoned _____

Date

ORVAL MANNSCHRECK

3-13-35 192

Scout

KANSAS

Map No. 49 Sec. 6 Twp. 20 R. 9WWell No. 6-PropittEmpire oil

Company

Contractor

COMPLETED

SECTION PLAT

Ft. from N. Line

990 Ft. from S. Line

Ft. from E. Line

990 Ft. from W. Line

Location

Rig up

Drilling and Remarks:

752 bbls
22 hrs

RECORD

Cased in, ft.

Sand Silicious 3254

Gas

Oil

Total Depth 3259

PRODUCTION

1st 24 hrs. Nat.

1st 24 hrs. after shot

Gas Cu. Ft.

Dry Hole

Abandoned

Date

5-8-35 192ORVAL MANNSCHRECK
Scout