

KANSAS

Section 6 Township 20 Range 9W
Well No. #7 Christopher
Company Branine & Holl

NORTH

WEST

EAST

SOUTH

Rice
20

KANSAS

9W ✓

Sec. 6 Twp. 20 R. 9W

Well No. #7 Christopher Farm

Branine & Holl

Company

Pickrell Drlg.

Contractor

Chase Pool


990 Ft. from N. Line

Ft. from S. Line

Ft. from E. Line

330' Ft. from W. Line

SW NW NW

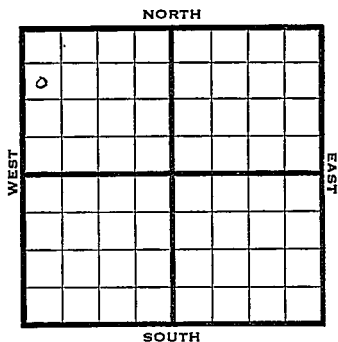

1949

Elev. 1735' REPORT

11/2

Location

11/9

"

11/16

"

11/23

8" @ 238'

11/29

TD 2278'

12/7

Arb. 3274'

TD 3282'

5" @ 3273'

12/14

Arb 3274'

5" @ 3273'

Pump 50 oil Pot.

Gr. 42°

TD 3285'

COMPLETED

Kansas

Map No. _____ Sec. 6 Twp. 20 R. 9WWell No. 7 Christopher_____Brangine & Holl_____Company_____Pickrell Drlg._____Contractor

SW NW NW

FIRST REPORT
SECTION PLAT990 Ft. from N. Line_____Ft. from S. Line_____Ft. from E. Line330 Ft. from W. Line

o			

Rice County

Location X

Rig up _____

Drilling and Remarks: _____

RECORD

Cased _____ in., _____ ft.

Sand _____

Gas _____

Oil _____

Total Depth _____

PRODUCTION

1st 24 hrs. Nat. _____

1st 24 hrs. after shot _____

Gas _____ Cu. Ft.

Dry Hole _____

Abandoned _____

Date

NOV 2 1949 19 S. J. LEWIS Scout

Map No. _____ Sec. 6 Twp. 20 R. 9W

Well No. 7 Christopher

Branine & Holl Company

COMPLETE

Contractor

SW NW NW

E 1,1785
SECTION PLAT

990 Ft. from N. Line

_____ Ft. from S. Line

_____ Ft. from E. Line

330 Ft. from W. Line

<i>d</i>			

Rice County

Location _____

Rig up _____

Drilling and Remarks:

Core 3274

5" C 3273

Run 50 oil 100

42 2 1/2

RECORD

Cased _____ in., _____ ft.

Sand _____

Gas _____

Oil _____

Total Depth 3275

PRODUCTION

1st 24 hrs. Nat. _____

1st 24 hrs. after shot _____

Gas _____ Cu. Ft.

Dry Hole _____

Abandoned _____

Date

DEC 14 1949

19

S. J. LEWIS

Scout