

WEST

EAST

SOUTH

0

KANSAS

Rice

Sec. 6 Twp. 20 R. 9W

Well No. #7 Hilton Farm

Ramsey Pet.

Company

Chase Pool

 Ft. from N. Line

990'


 Ft. from S. Line

 Ft. from E. Line

330'

 Ft. from W. Line

NW SW SW

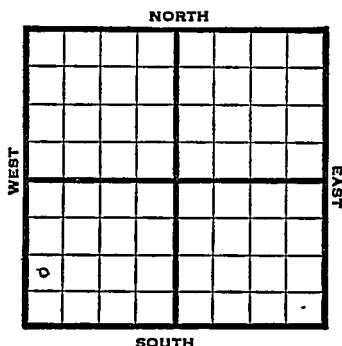

1948

Eli 1736'

R E P O R T

9/8

8" @ 238'
Drlg. 1794'

9/14

Lansing 2944' -
Simpson sand 3263-65'
TD 3265'
Run 5"

9/21

5" @ 3263' - 120 shots 3028-52
1000 acid swb 30 bbls oil & 55 W
in 18 hrs.

9/29

"

10/6

Arbuckle 3275'
TD 3276 $\frac{1}{2}$

10/13

"

10/20

TD 3276'
Simp Sd 3263'
5" @ 3263'
Arb. 3269'
Pump 50 Oil Pot
44° Gr.
Comp

COMPLETED

Map No. 49 Sec. 6- Twp. 20 R. 9W

Well No. 7 Hilton "A"

Ramsey Pet.

Company

COMPLETE

Contractor

NW SW SW


E11736
SECTION PLAT

 Ft. from N. Line

990 Ft. from S. Line

 Ft. from E. Line

330 Ft. from W. Line

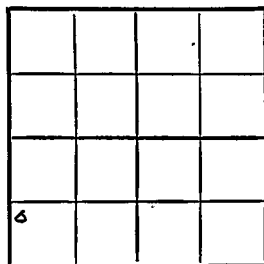

Rice County

RECORD

Location

Rig up

Drilling and Remarks: .

Shut Sol 3263

3263

3269

Run 500 ft

44° E

Cased in., ft.

Sand

Gas

Oil ✓

Total Depth 3276

PRODUCTION

1st 24 hrs. Nat.

1st 24 hrs. after shot

Gas Cu. Ft.

Dry Hole

Abandoned

Date

OCT 20 1948

19

S. J. LEWIS

Scout