


Section 6 Township 20 Range 9W

Well No. #7 Hilton

Company Floyd Ramsey

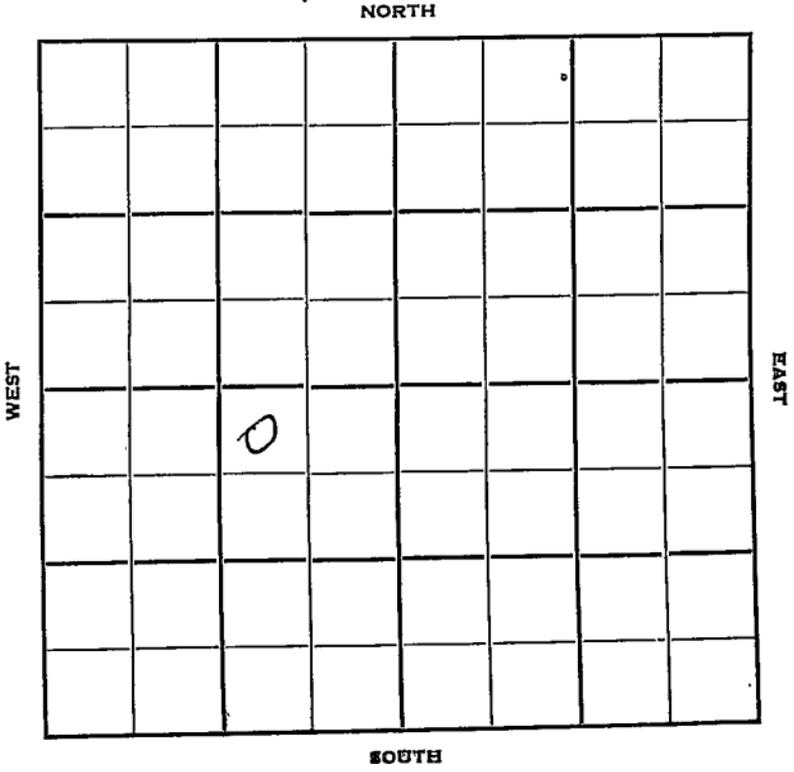

Rice

KANSAS

Sec. 6 Twp. 20 R. 9W

Well No. #7 Hilton Farm

Floyd Ramsey Company

Chase Pool Contractor


330' Ft. from N. Line

_____ Ft. from S. Line

990' Ft. from E. Line

_____ Ft. from W. Line

NW NE SW

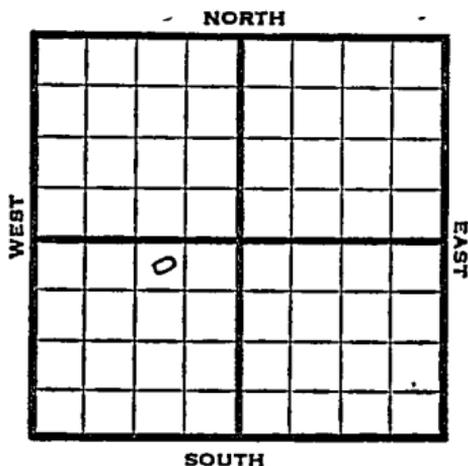

1951 Elev. 1733' REPORT

10/24 Spud 10-19-51
8" @ 202
Drlg. 1575'

11/14 Spud 10-19-51
SWD well TD 3564
8" @ 202
Br. lime 2921 Lans. 2947
Arb. 3278 TD 3564
5" @ 3285
Comp. for SWD well
Abandoned

ABANDONED

County Rice State Kansas

Sec. 6 (Blk. 20) (Sur. 9W) Map No.

Operator Floyd Ramsey

Well No. 7 Farm Hilton

Elev. 1733 Location NW NE SW

<p>ABANDONED COMPLETE</p>			

330 Ft. From N Line SW

990 Ft. From E Line Quarter

Ist. Report

Completion NOV 14 1951

Remarks Chase Pool

Spudding Date 10-19-51

Drlg. Data SWD well TD 3564

8" @ 202 Br. line 2921 Lans. 2947

Arb. 3278 TD 3564 5" @ 3285

Comp. for SWD well