

Map No. KANSAS Sec

Well No.

Sec


Twp.

R.

## Farm

Company

**NORTH**

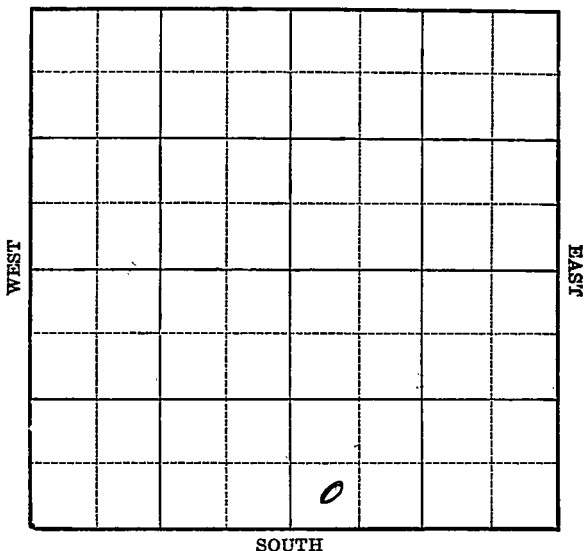

### Location

### Drilling Remarks

## Rig Up.

### Drilling Remarks

## RECORD

Cased\_\_\_\_\_in. \_\_\_\_\_ft.

# Sand

# Gas

## Oil

Total Depth\_\_\_\_\_

## PRODUCTION

1st 24 hrs. Nat.-----

1st 24 hrs. after shot\_\_\_\_\_

Gas \_\_\_\_\_ cu. ft. \_\_\_\_\_

**Dry Hole**\_\_\_\_\_

Abandoned\_\_\_\_\_


Map No. 6 Sec. 6 Twp. 20 R. 9W  
Well No. 7- Proffitt Farm  
Empire Oil Company

       Ft. from N. Line

330 Ft. from S. Line

       Ft. from E. Line

330 Ft. from W. Line

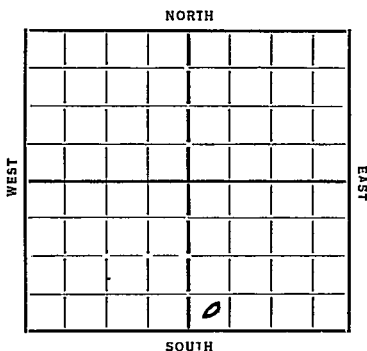

Date 1935

REPORT

3/20 Bldg Rig  
3/28 15" M5 WOC  
4/4 Bldg 2448  
4/11 7" 3231 WOC  
4/18 Bldg plug  
4/26 Sump 3252 Sil 3282  
60' 6" liner 3280  
S.O. 3298-3302  
5/3 Bldg Rig Bit 3340  
" " 3423  
HFW 3416-19 Bldg  
5/9 Bldg 3253  
5/16 5" 3588  
5/29 — 5/29 — 6/6 — 6/13 —  
6/20 Bldg 1975  
6/28 — 7/3 —  
7/11 Bldg 1901  
7/18 " 2371  
8/8 Bldg Rig 2476  
8/15 —  
8/22 Bldg 2625  
8/29 " 3055 KC 2977

(OVER)

9/6 Wly 3300

9/20 Lib 3311

TJ 3318

276 Pbls.

COMPLETED

Form 26-1M-Bld. 9-28

Map No. 49 Sec. 6 Twp. 20 R. 9WWell No. 7-ProffittEmpire oil Company

Contractor

## FIRST REPORTS

Ft. from N. Line

330 Ft. from S. Line

Ft. from E. Line

330 Ft. from W. Line

## SECTION PLAT

|  |  |   |  |
|--|--|---|--|
|  |  |   |  |
|  |  |   |  |
|  |  |   |  |
|  |  | 0 |  |

Location

Rig up

Drilling and Remarks:

Bedg Rig

## RECORD

Cased \_\_\_\_\_ in., \_\_\_\_\_ ft.

Sand \_\_\_\_\_

Gas \_\_\_\_\_

Oil \_\_\_\_\_

Total Depth \_\_\_\_\_

## PRODUCTION

1st 24 hrs. Nat. \_\_\_\_\_

1st 24 hrs. after shot \_\_\_\_\_

Gas \_\_\_\_\_ Cu. Ft.

Dry Hole \_\_\_\_\_

Abandoned \_\_\_\_\_

ORVAL MANNSCHRECK

Date

3-20-35 192 Scout

Map No. 49 Sec. 6 Twp. 20 R. 9N

Well No. 7-Proffitt

Empire oil Company

Contractor

**COMPLETED**

**KANSAS**

**SECTION PLAT**

Ft. from N. Line

330 Ft. from S. Line

Ft. from E. Line

330 Ft. from W. Line

|  |  |  |  |
|--|--|--|--|
|  |  |  |  |
|  |  |  |  |
|  |  |  |  |
|  |  |  |  |
|  |  |  |  |

Location.....

Rig up.....

Drilling and Remarks:

276 bbls

**RECORD**

Cased in ft.

Sand 3311

Gas.....

Oil.....

Total Depth 3318

**PRODUCTION**

1st 24 hrs. Nat. ....

1st 24 hrs. after shot.....

Gas..... Cu. Ft.

Dry Hole.....

Abandoned.....

Date

**CAVAL MANNSCHRECK**

9-20-35 192

Scout