

KANSAS


RICE

Form 51-5M-4-36-Palace

Section 6 Township 20 Range 9-W

Well Number 12-Proffitt

Company Empire

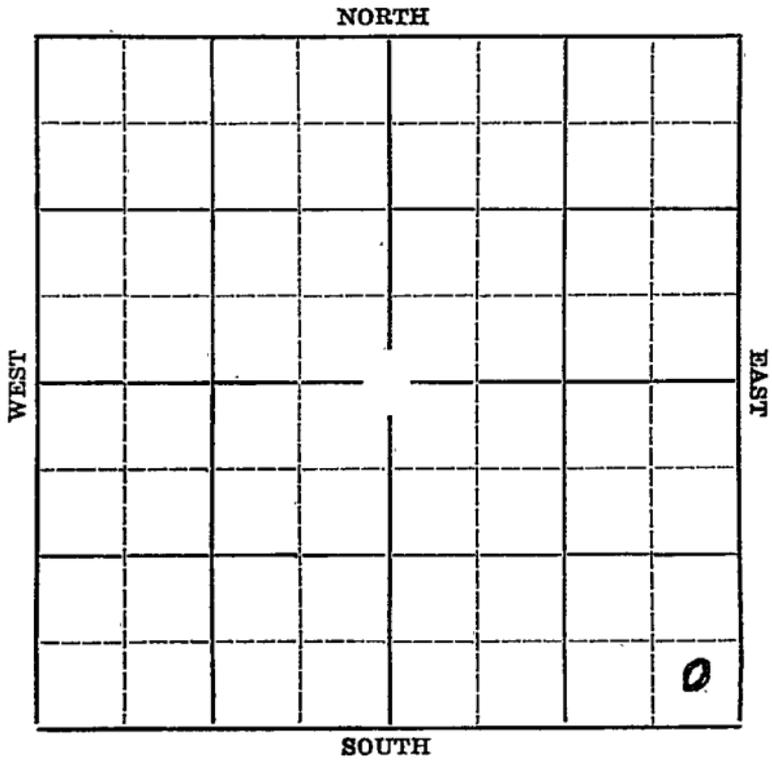

**KANSAS**

Map No. \_\_\_\_\_ Sec. 6 Twp. 20 R. 9-W

Well No. 12-Proffitt Farm \_\_\_\_\_

Empire Company \_\_\_\_\_


\_\_\_\_\_ Ft. from N. Line

330 Ft. from S. Line

330 Ft. from E. Line

\_\_\_\_\_ Ft. from W. Line

Elev. 1725

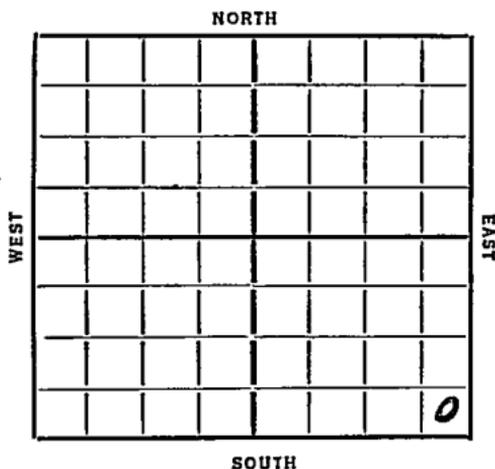

Date  
1936

**REPORT**

4/15 Location

4/23 Building rig.

4/30 Rigging up.

5/7 Spud.

5/14 DrLg. 1750'.

5/21 DrLg. 2910'.

5/28 8" @ 3215'. Rigging up st'd. tools

6/4 Drlg. cement.

6/11 Sil. 3244'. Set 5". T.D. 3245'.

1000 gallons acid 229 bbls in 24 hr

6/24/36-Sil. 3222'.

3000 gallons acid.

T.D. 3253'.

805 bbls potential.

**COMPLETED**

*Rice*  
Map No. 49 Sec. 6 Twp. 20 R. 9W

Well No. 12 Proffitt

Empire Company

Contractor

## SECTION PLAT

..... Ft. from N. Line

330 Ft. from S. Line

330 Ft. from E. Line

..... Ft. from W. Line

			0

## FIRST REPORT

Location

Rig up.....

Drilling and Remarks:

## RECORD

Cased..... in., ..... ft.

Sand.....

Gas.....

Oil.....

Total Depth.....

## PRODUCTION

1st 24 hrs. Nat.....

1st 24 hrs. after shot.....

Gas..... Cu. Ft.

Dry Hole.....

Abandoned.....

Date

AR 15 192..... S. J. LEWIS Scout

Map No. 29 Sec. 6 Twp. 20 R. 9W

Well No. 12 Proffitt

Empire Company

Contractor

SECTION PLAT


\_\_\_\_\_ Ft. from N. Line

330 Ft. from S. Line

330 Ft. from E. Line

\_\_\_\_\_ Ft. from W. Line

COMPLETED

RECORD

Location \_\_\_\_\_

Cased \_\_\_\_\_ in., \_\_\_\_\_ ft.

Rig up \_\_\_\_\_

Sand \_\_\_\_\_

Drilling and Remarks:

Gas \_\_\_\_\_

Oil 3222

Oil \_\_\_\_\_

Total Depth 3253

3000 acid

PRODUCTION

1st 24 hrs. Nat. \_\_\_\_\_

1st 24 hrs. after shot \_\_\_\_\_

Gas \_\_\_\_\_ Cu. Ft.

Dry Hole \_\_\_\_\_

Abandoned \_\_\_\_\_

Date

JUN 24 1936 19

S. J. LEWIS Scout